


RECEIVED
City of Karratha

11 JAN 2016

Planning Department

SITE PLAN

1:200

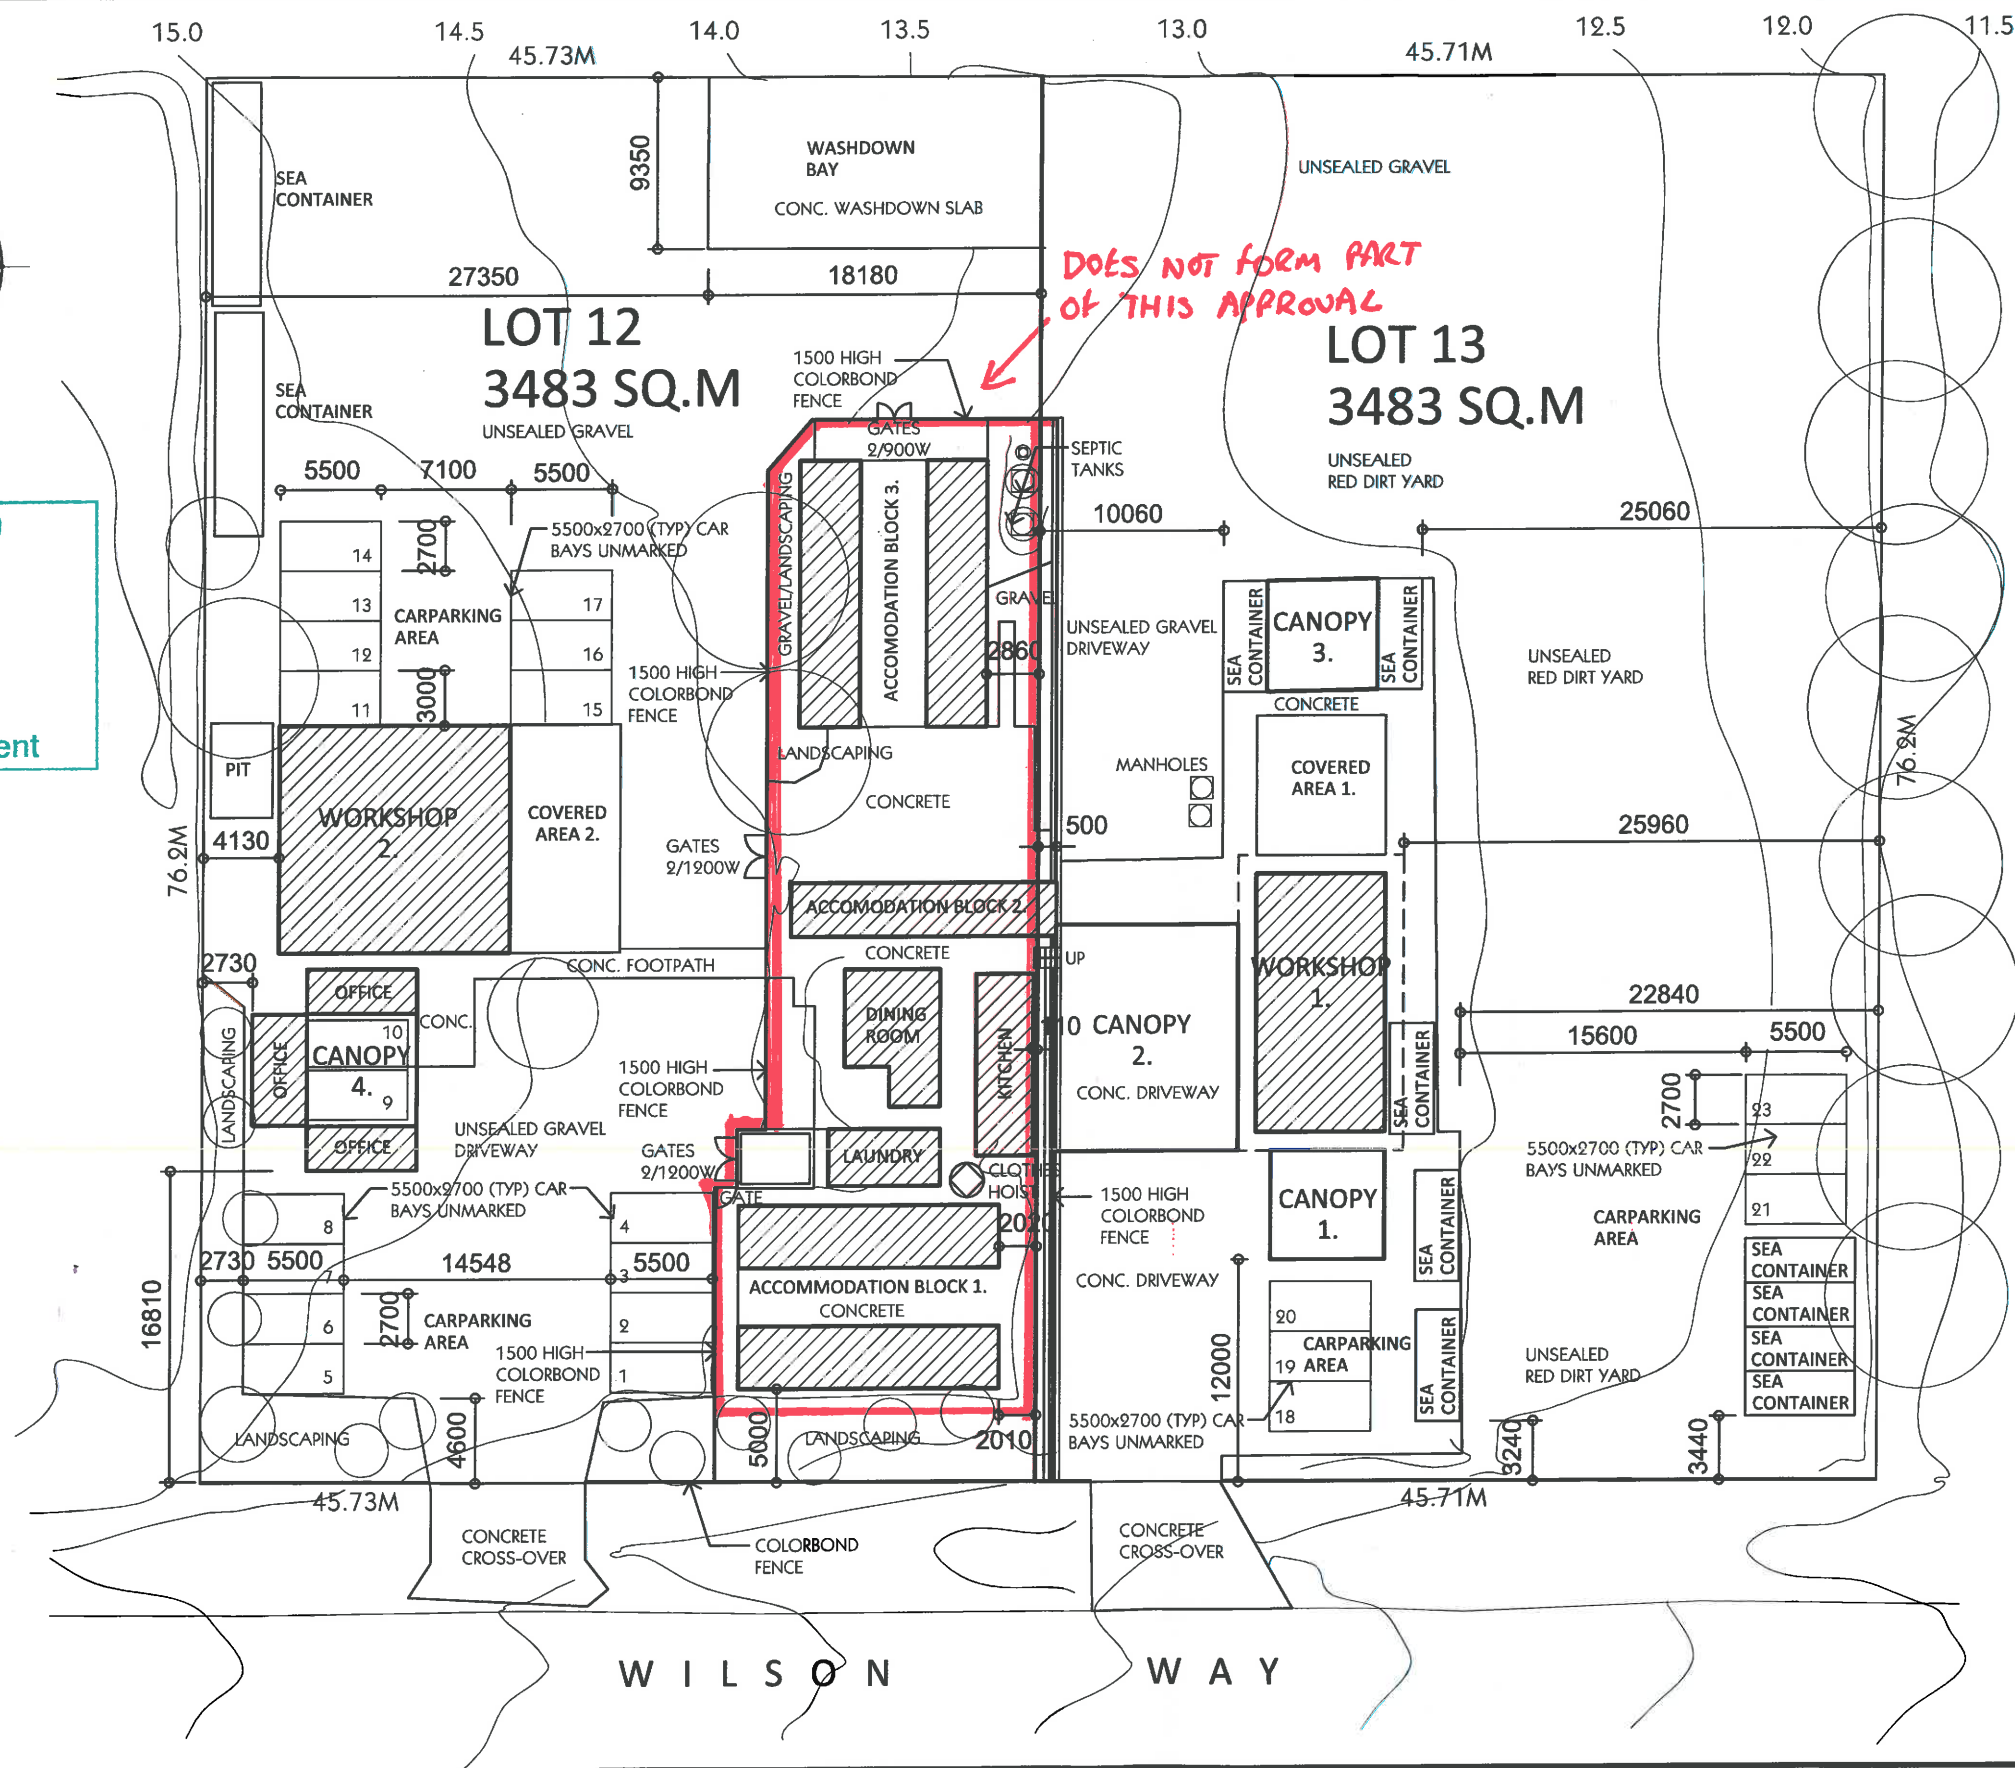

SITE BOUNDARY NOTE
REFER TO FEATURE SURVEY PLAN
BY LAND SURVEYS
JOB No. 1329 DWG No. 1501329 REV A.

SITE MEASUREMENTS
THESE DRAWINGS HAVE BEEN
PREPARED BY SITE MEASUREMENT &
OBSERVATIONS OF ELEMENTS THAT
WERE VISIBLE AND ACCESSIBLE AT THE
TIME OF SURVEY. SOME ASSUMPTIONS
HAVE BEEN MADE IN THE PREPARATION
OF THESE DRAWINGS BASED ON THE
INFORMATION AVAILABLE. ALTHOUGH
THESE DRAWINGS PORTRAY A TRUE
REPRESENTATION OF THE STRUCTURES
ON THE SITE THEY SHOULD NOT BE USED
FOR CONSTRUCTION PURPOSES.

CARPARKING REQUIREMENTS
OFFICE AREAS - 1 BAY PER 30 SQ.M
INDUSTRIAL AREAS - 4 BAYS PER 200 SQ.M
& 1 BAY EVERY 100 SQ.M THEREAFTER
ACCOMMODATION - 1 BAY/0.5 ROOMS

LOT 12 REQUIRES 17 BAYS
LOT 13 REQUIRES 6 BAYS
TOTAL CARPARKING PROVIDED = 23 BAYS

CAR PARKING BAYS 2700 x 5500

				DESIGN	-	-
				DRAWN	AS	3/11/15
				CHECKED	L.R	17/11/15
				ENGINEER		
				ISSUED		
				CONTRACTOR TO CHECK ALL DIMENSIONS PRIOR TO COMMENCEMENT DIMENSIONS TO GOVERN SCALE		
REV	BY	DATE	DESCRIPTION	CKD	APP	
	A	AS	25/11/15	AS BUILT DRAWING ISSUE	L.R	

**L.E.ROBERTS BUILDING DESIGN**
ARCHITECTURAL DESIGN CONSULTANTS

Suite 2A 11 Hedland Place
PO Box 1279 Karratha 6714
Tel (08) 9144 2846
Fax (08) 9185 6990
Email: lawrence.roberts@laroberts.com.au
Web: laroberts.com.au



DIVERSE GROUP AUSTRALIA
7-9 WILSON WAY, WICKHAM
SITE PLAN

SCALE	1:200 (A3)
DRAWING No	815-01-01
REV	0
SHEET	1 OF 20

RECEIVED
City of Karratha

11 JAN 2016

Planning Department

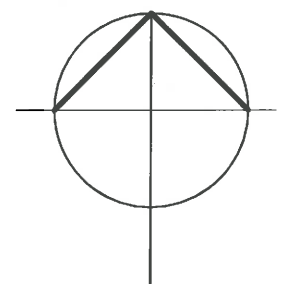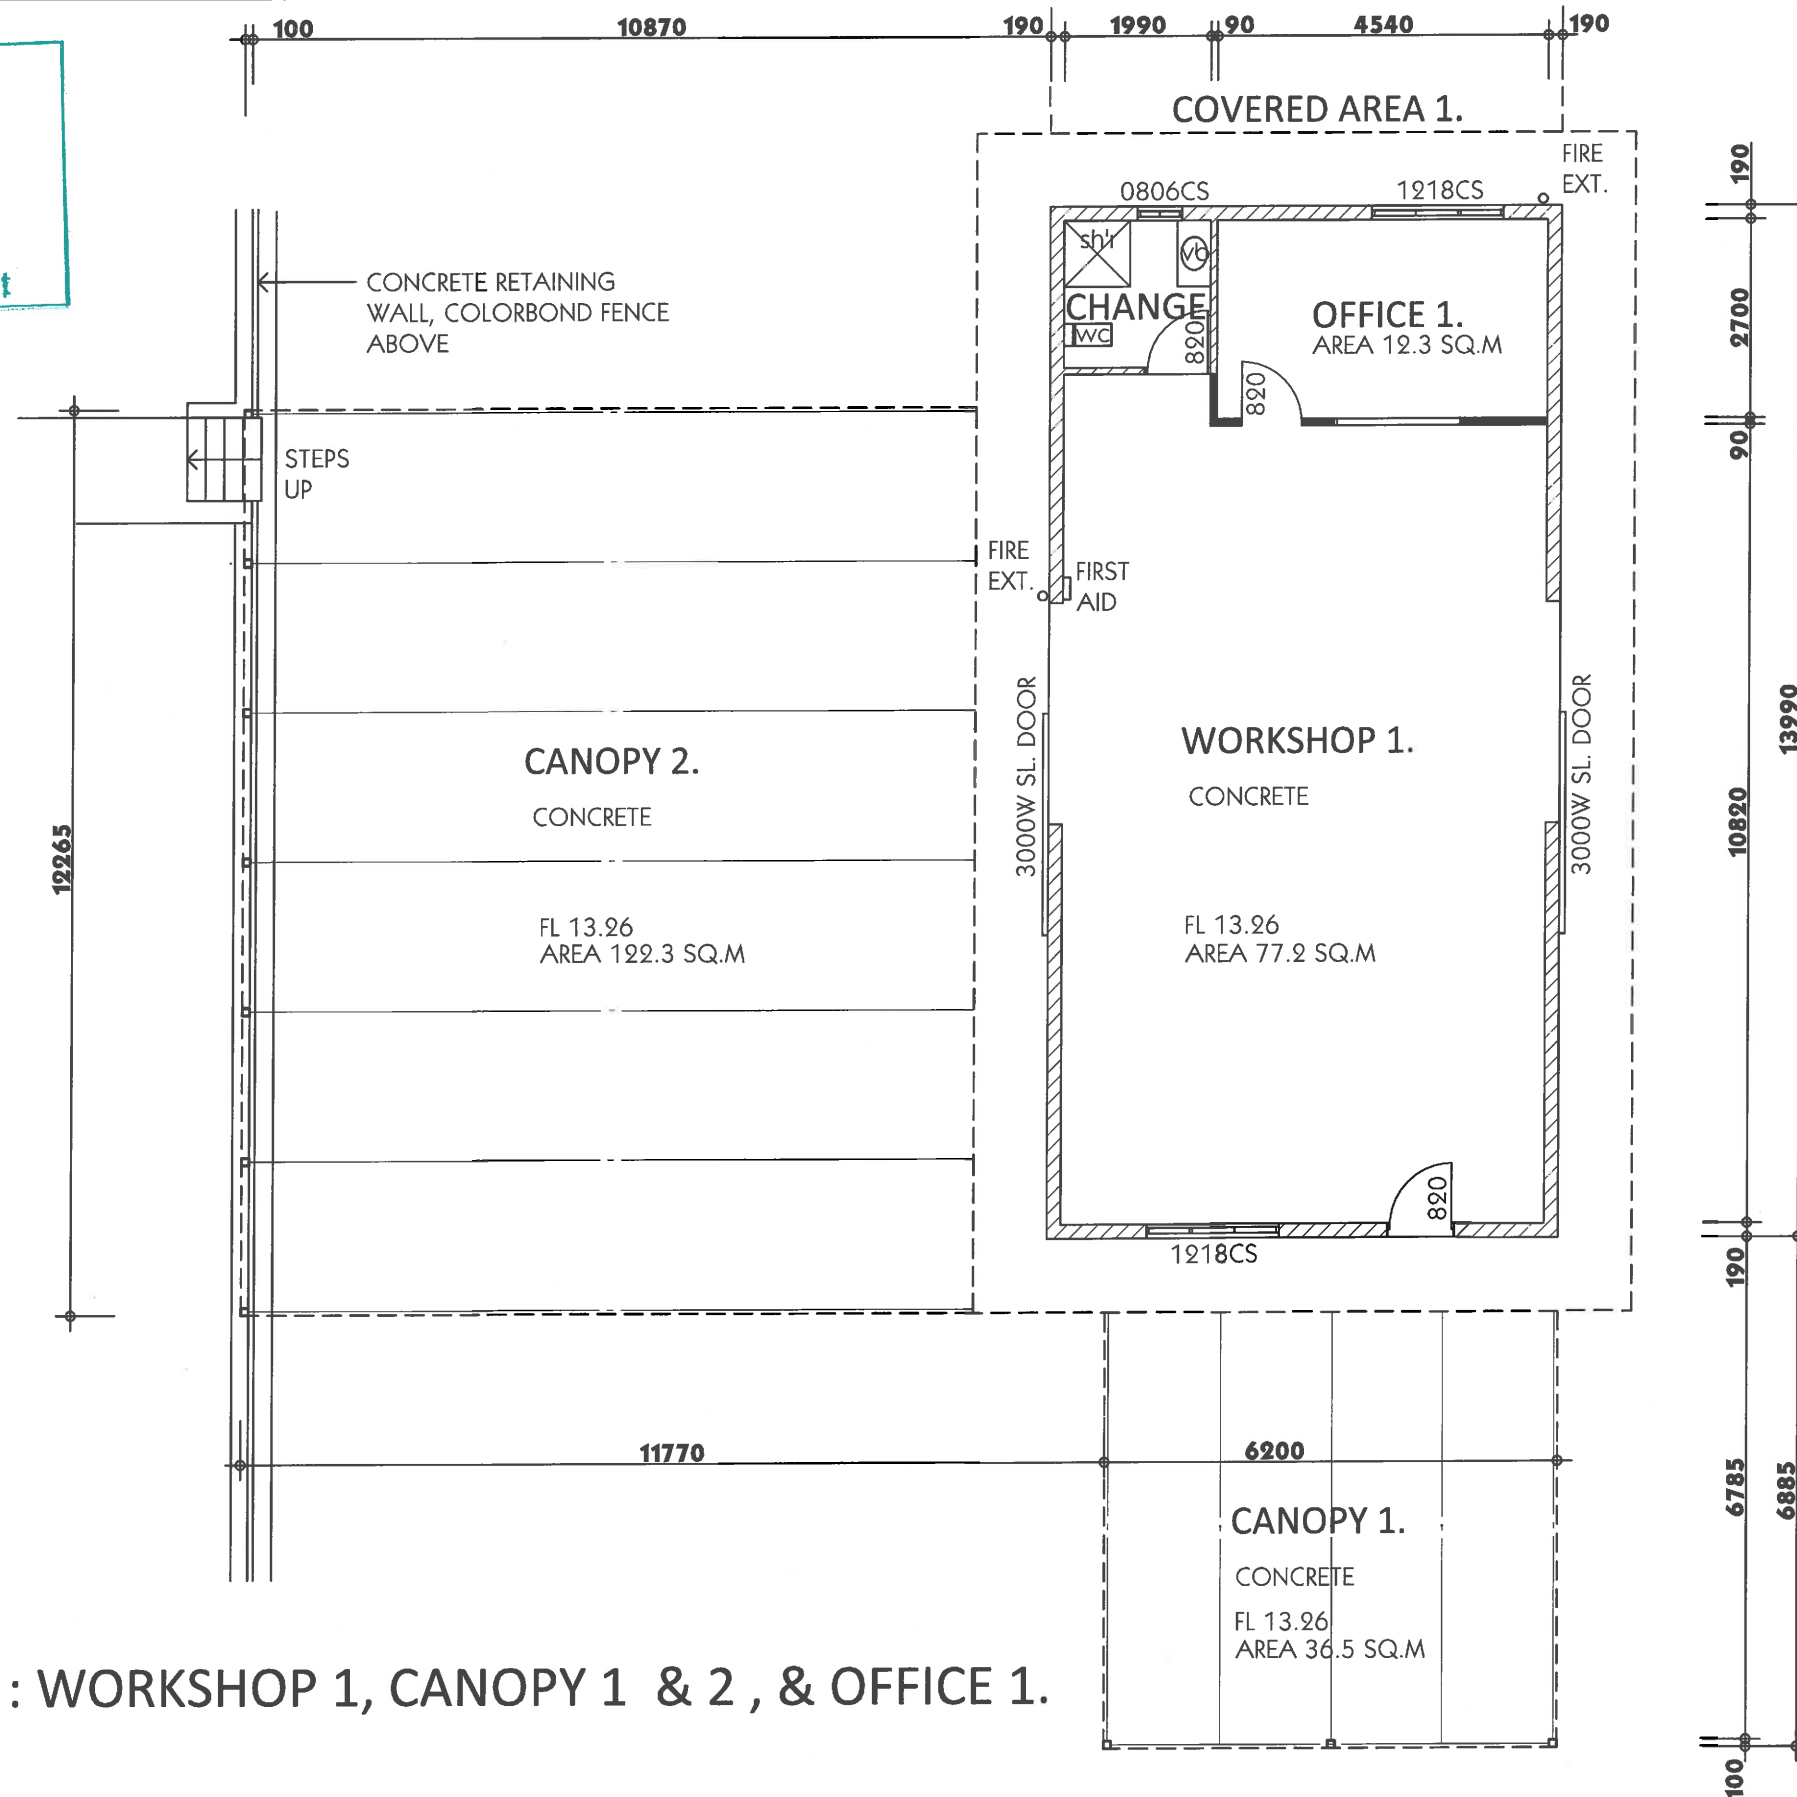

FLOOR PLAN : WORKSHOP 1, CANOPY 1 & 2 , & OFFICE 1.


1:100

REVISIONS				DESIGN		
				DRAWN	AS	3/11/15
				CHECKED	LER	17/11/15
				ENGINEER	-	-
				ISSUED		
0	AS	25-11-15	AS BUILT DRAWING ISSUE	LER		
REV	BY	DATE	DESCRIPTION	CKD	APP	
				CONTRACTOR TO CHECK ALL DIMENSIONS PRIOR TO COMMENCEMENT DIMENSIONS TO GOVERN SCALE		
				L.E.ROBERTS BUILDING DESIGN ARCHITECTURAL DESIGN CONSULTANTS		
				DIVERSE GROUP AUSTRALIA 7-9 WILSON WAY, WICKHAM WORKSHOP 1, CANOPY'S 1 & 2, OFFICE 1 FLOOR PLAN		
				SCALE 1:100 (A3)		
				DRAWING No 815-01-02 0		
				SHEET 2 OF 20		


THIS IS A CAD DRAWING
DO NOT AMEND MANUALLY

RECEIVED
City of Karratha
11 JAN 2016

Planning Department

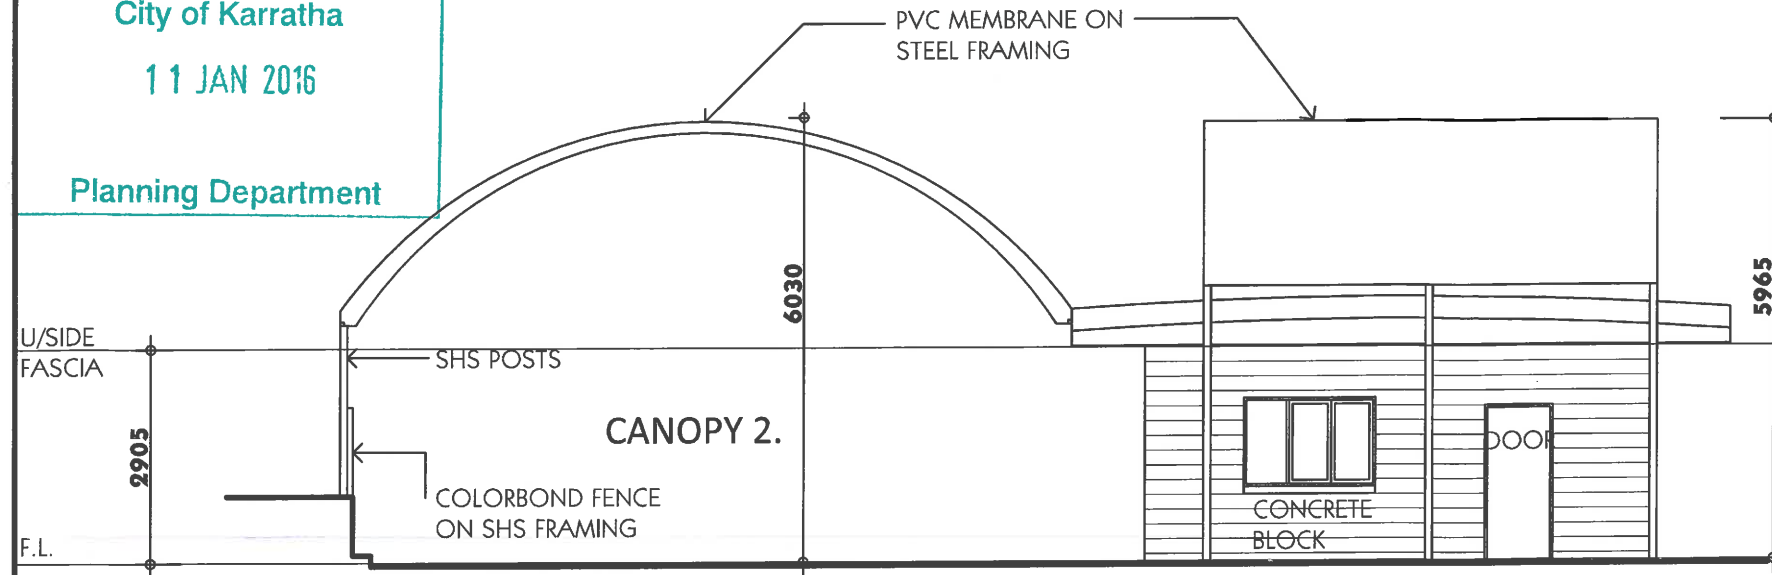

SOUTH ELEVATION
1:100

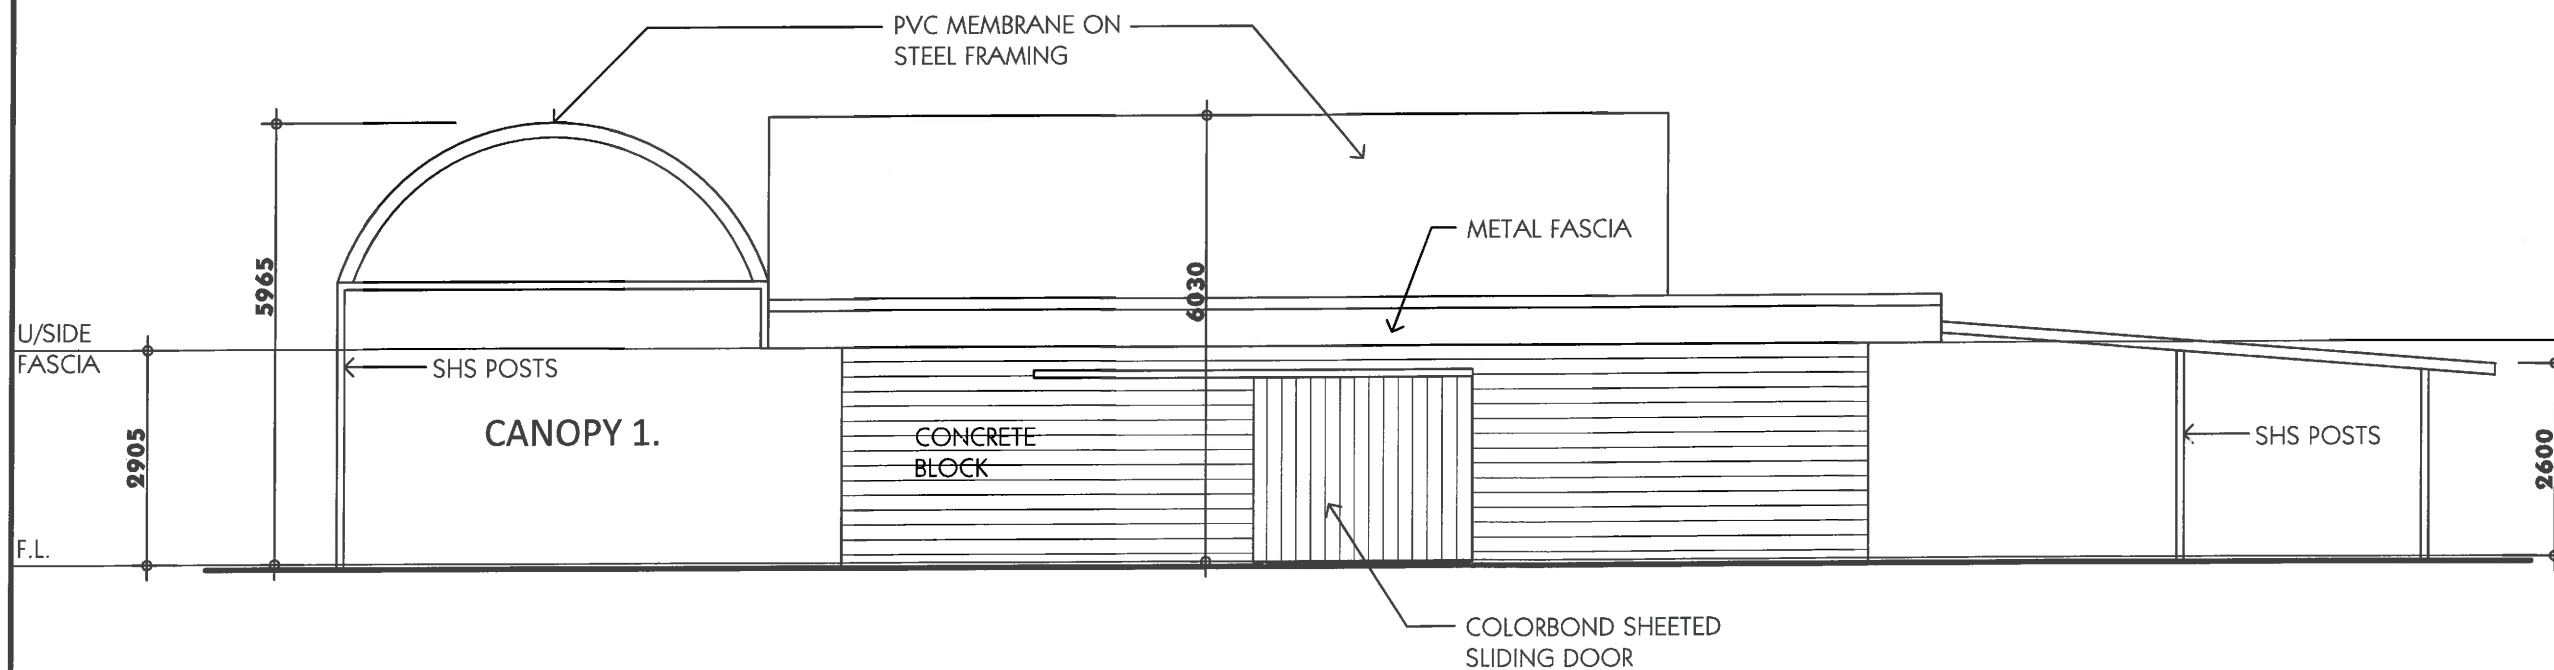

EAST ELEVATION
1:100

REV	BY	DATE	DESCRIPTION	CKD	APP	DESIGN	DRAWN	AS	3/11/15
0	AS	25-11-15	AS BUILT DRAWING ISSUE	LER		CHECKED	LER		17/11/15
						ENGINEER			
						ISSUED			
						CONTRACTOR TO CHECK ALL DIMENSIONS PRIOR TO COMMENCEMENT			
						DIMENSIONS TO GOVERN SCALE			

L.E.ROBERTS BUILDING DESIGN		ARCHITECTURAL DESIGN CONSULTANTS		SCALE		DRAWING No		SHEET	
DIVERSE GROUP AUSTRALIA		7-9 WILSON WAY, WICKHAM		WORKSHOP 1, CANOPY'S 1 & 2, OFFICE 1		ELEVATIONS		3 OF 20	
815-01-03		A		1:100 (A3)					


THIS IS A CAD DRAWING
DO NOT AMEND MANUALLY

RECEIVED

City of Karratha


11 JAN 2016

Planning Department

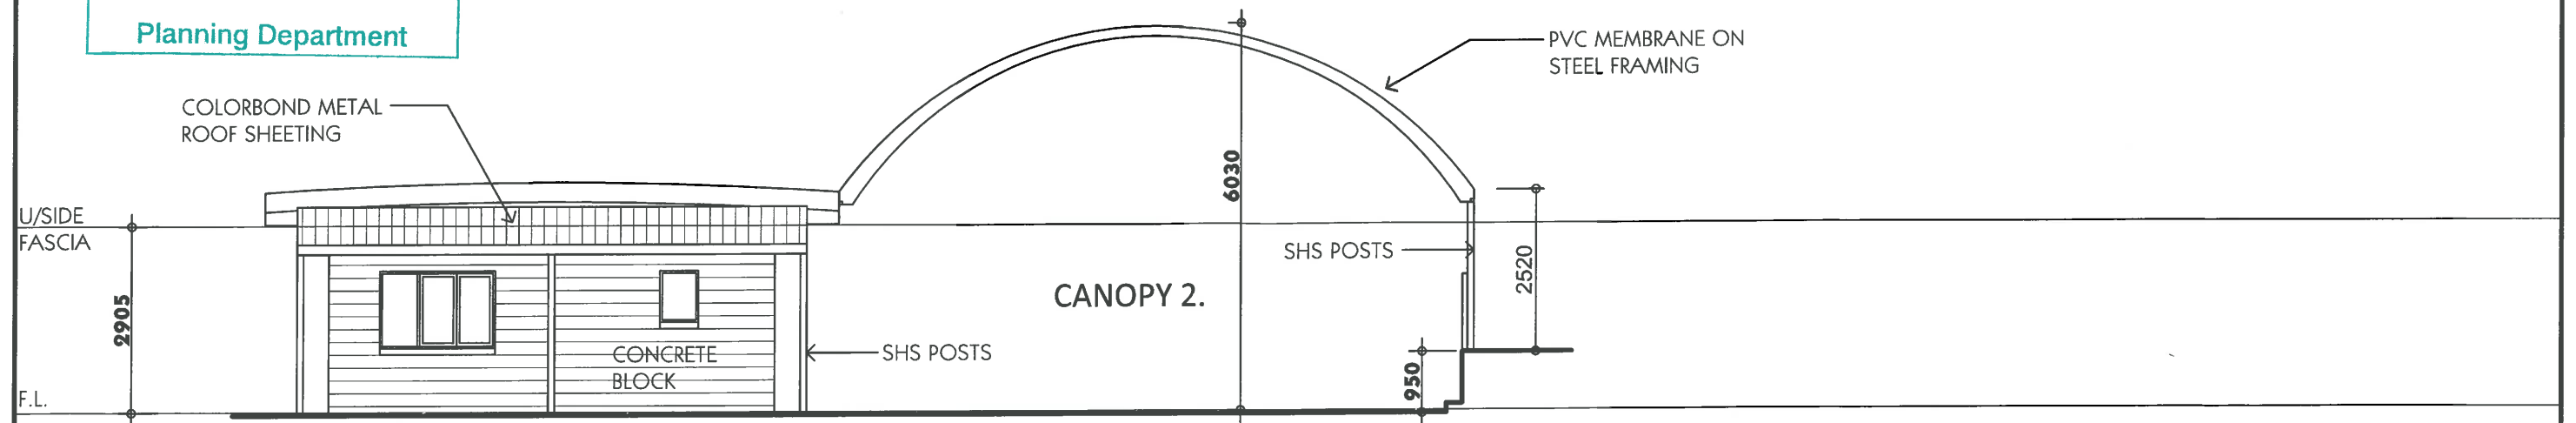

NORTH ELEVATION

1:100

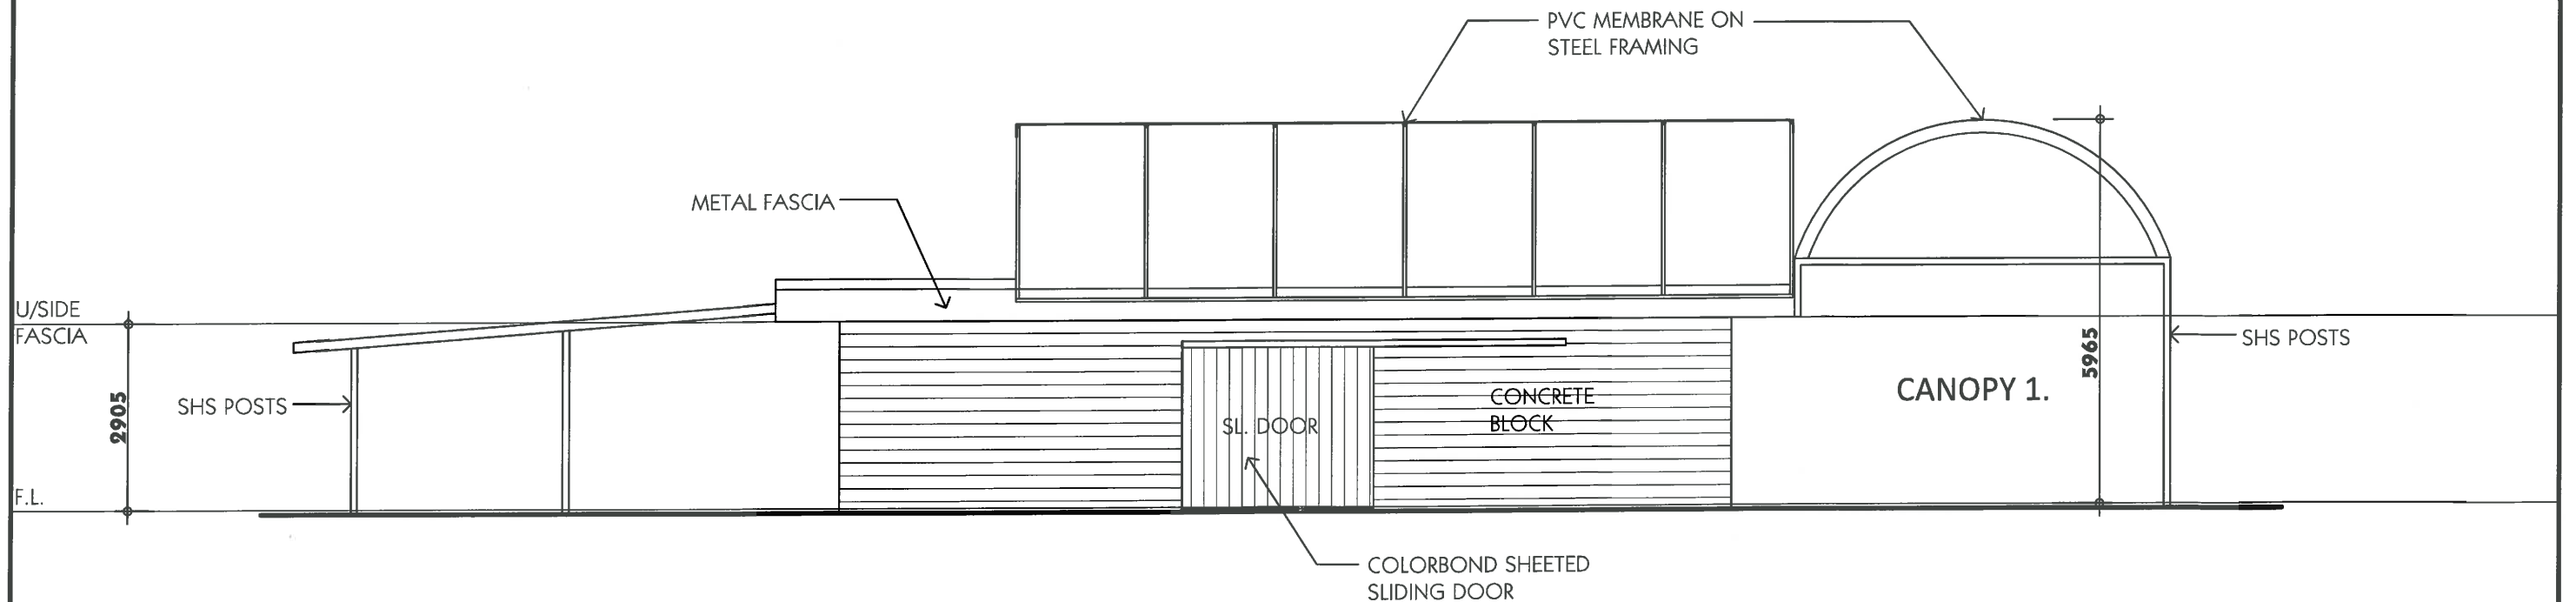

WEST ELEVATION

1:100

REVISIONS					DESIGN		
					DRAWN	AS	3/11/15
					CHECKED	LER	17/11/15
					ENGINEER	-	-
					ISSUED		
					CONTRACTOR TO CHECK ALL DIMENSIONS PRIOR TO COMMENCEMENT		
					DIMENSIONS TO GOVERN SCALE		
0	AS	25-11-15	AS BUILT DRAWING ISSUE		LER		
REV	BY	DATE	DESCRIPTION		CKD	APP	

L.E.ROBERTS BUILDING DESIGN		<small>Suite 2A 11 Hedland Place PO Box 1219 Karratha 6714 Tel (08) 9164 2046 Fax (08) 9165 6990 Email: lawrence.roberts@leroberts.com.au Web: leroberts.com.au</small>
ARCHITECTURAL DESIGN CONSULTANTS		
DIVERSE GROUP AUSTRALIA 7-9 WILSON WAY, WICKHAM WORKSHOP 1, CANOPY'S 1 & 2, OFFICE 1 ELEVATIONS		
SCALE	1:100 (A3)	
DRAWING No	815-01-04	0
SHEET	4 OF 20	

THIS IS A CAD DRAWING
DO NOT AMEND MANUALLY


RECEIVED

City of Karratha

11 JAN 2016


Planning Department

200 DEEP CONCRETE
PIT

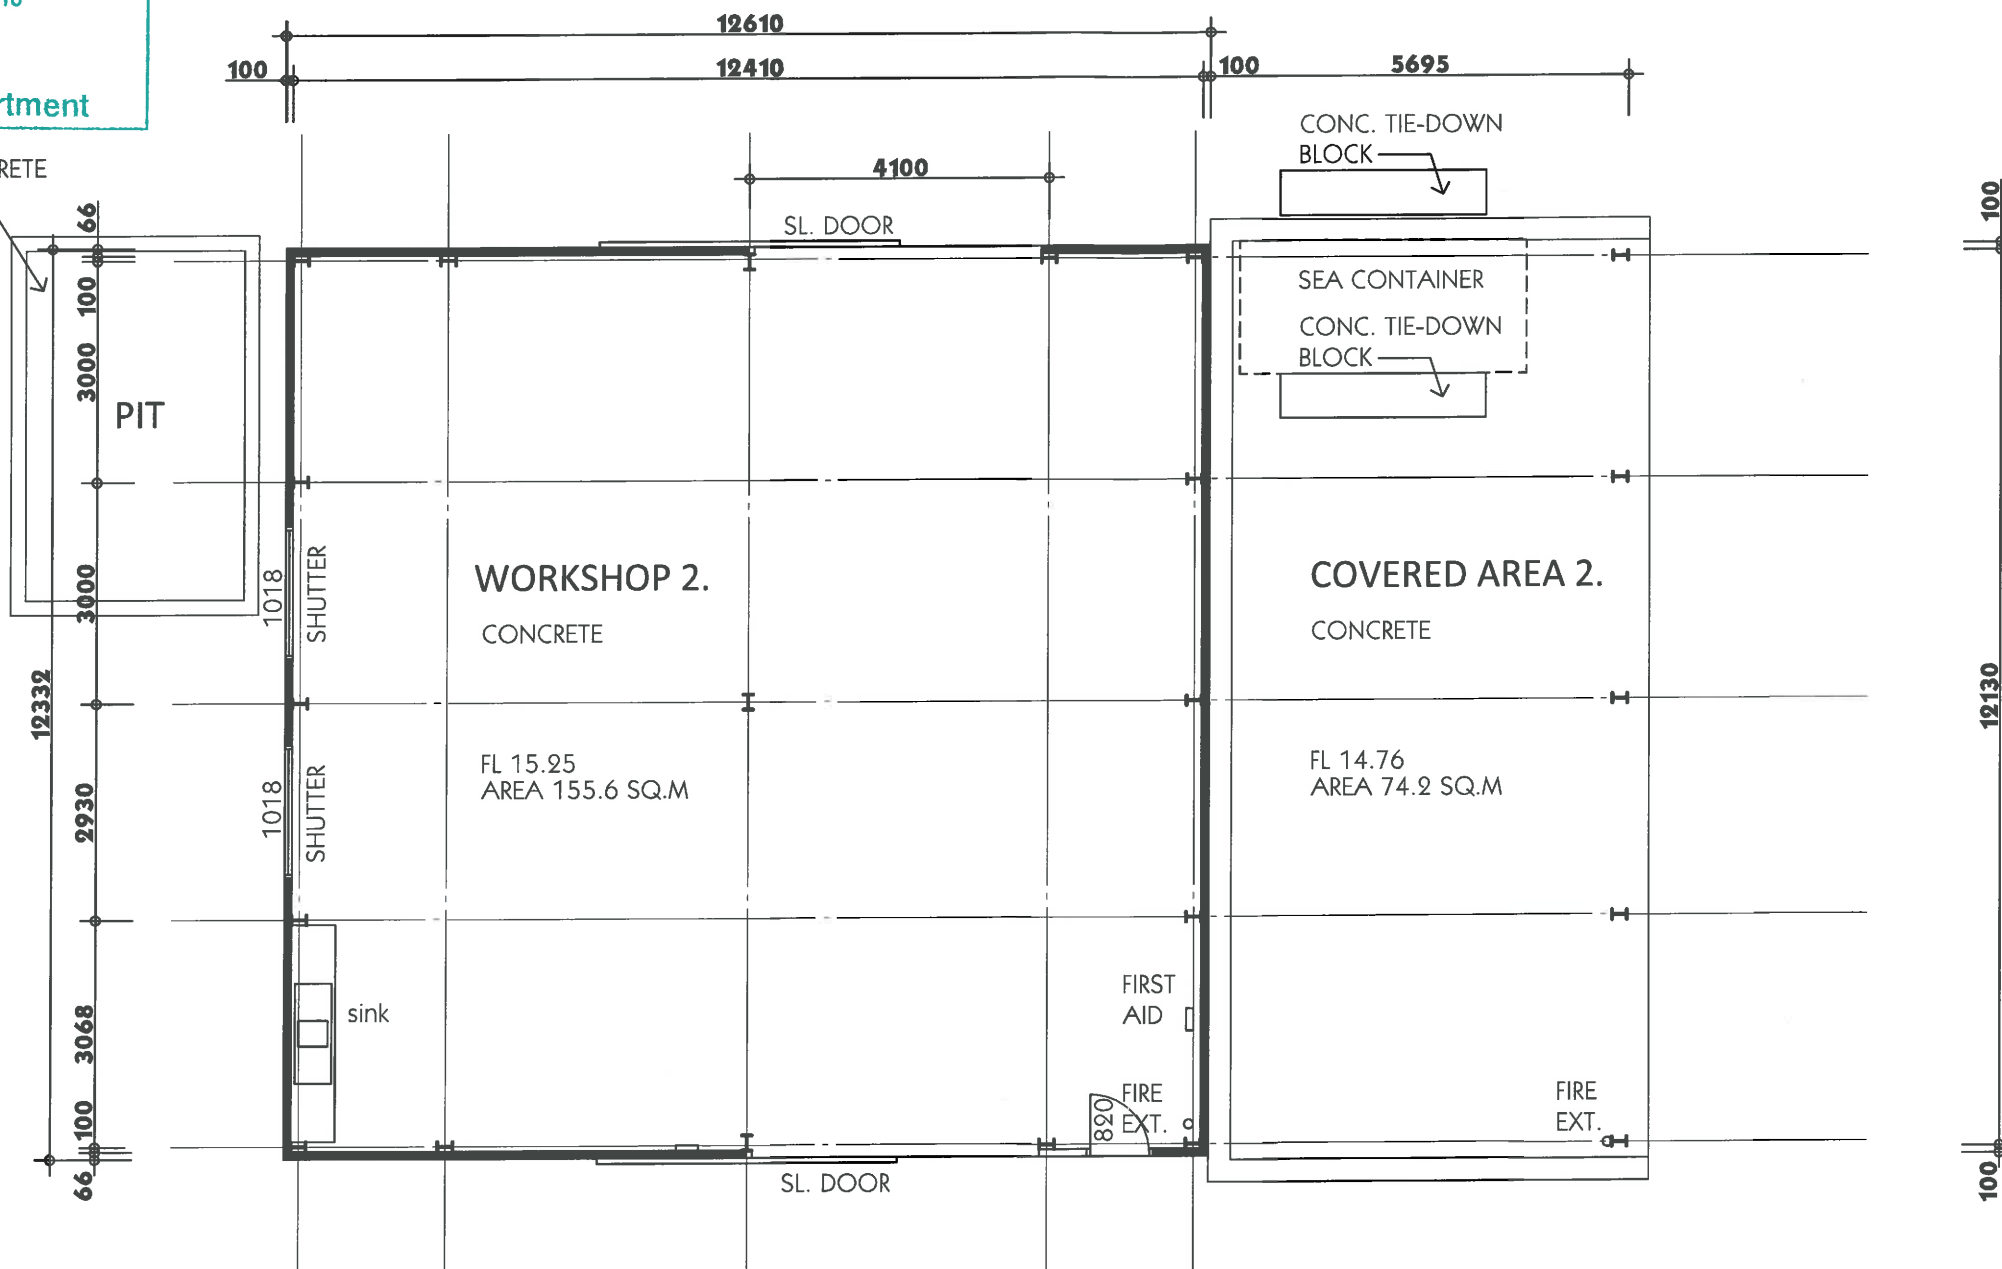

FLOOR PLAN : WORKSHOP 2 & COVERED AREA 2

1:100

REVISIONS							DESIGN			L.E.ROBERTS BUILDING DESIGN ARCHITECTURAL DESIGN CONSULTANTS <small>Suite 2A 11 Hedland Place PO Box 5219 Karratha 6714 Tel (08) 9145 2046 Fax (08) 9185 6990 Email: lawrence.roberts@leroberts.com.au Web: leroberts.com.au</small>			
							DRAWN	AS					3/11/15
							CHECKED	LER					17/11/15
							ENGINEER	-					-
							ISSUED						
0	AS	25-11-15	AS BUILT DRAWING ISSUE		LER		CONTRACTOR TO CHECK ALL DIMENSIONS PRIOR TO COMMENCEMENT			SCALE 1:100 (A3)			
REV	BY	DATE	DESCRIPTION		CKD	APP	DIMENSIONS TO GOVERN SCALE			DRAWING No 815-01-05	0		
											SHEET	5 OF 20	


THIS IS A CAD DRAWING
DO NOT AMEND MANUALLY

RECEIVED

City of Karratha


11 JAN 2016

Planning Department

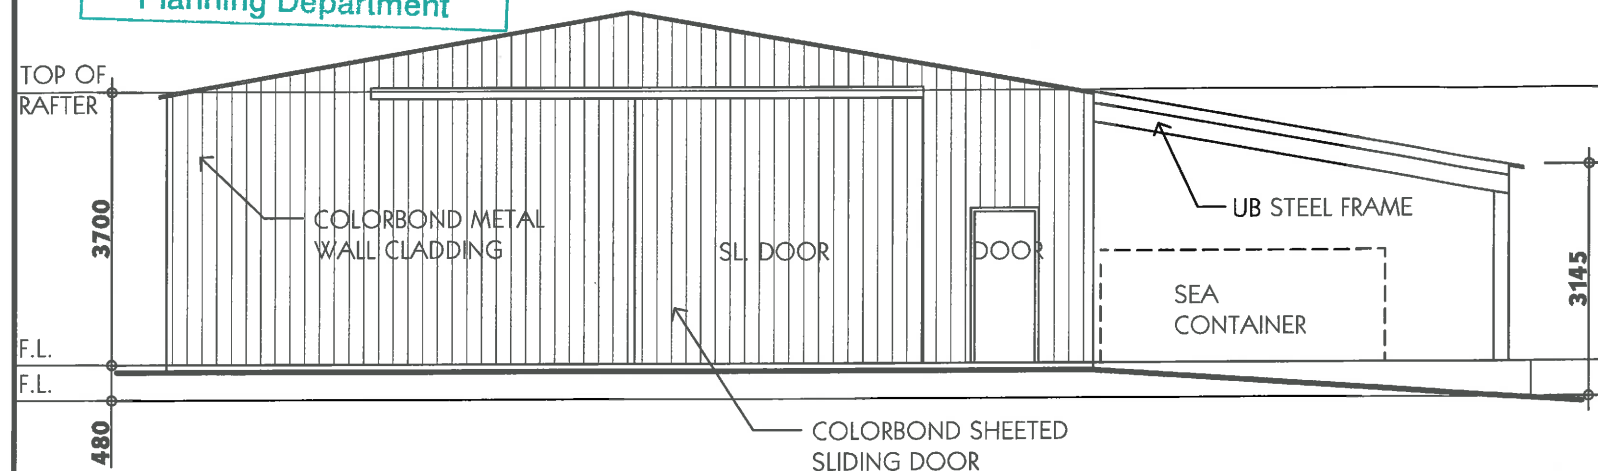


SOUTH ELEVATION

1:100

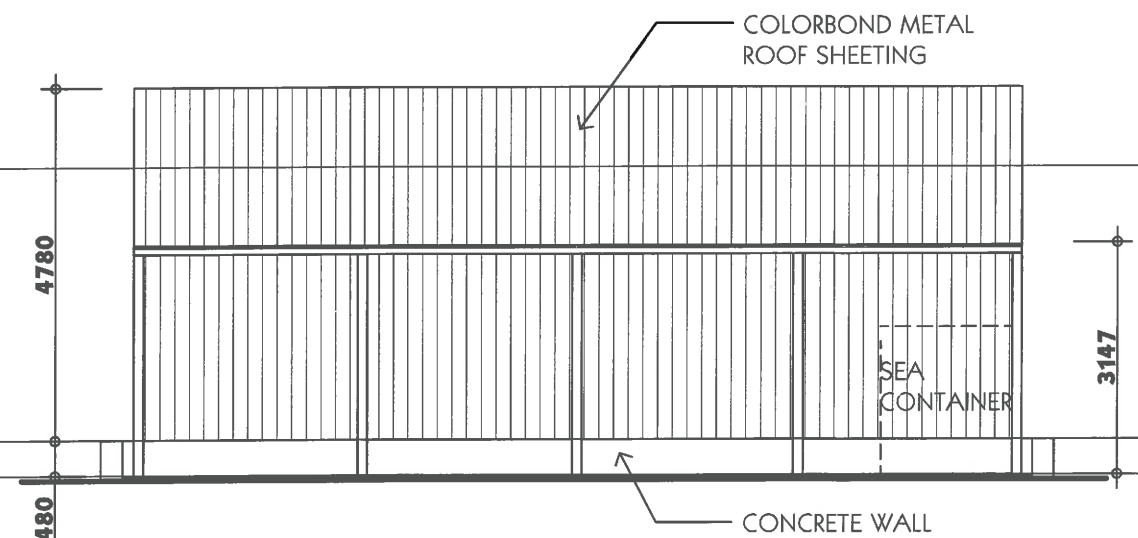


EAST ELEVATION

1:100

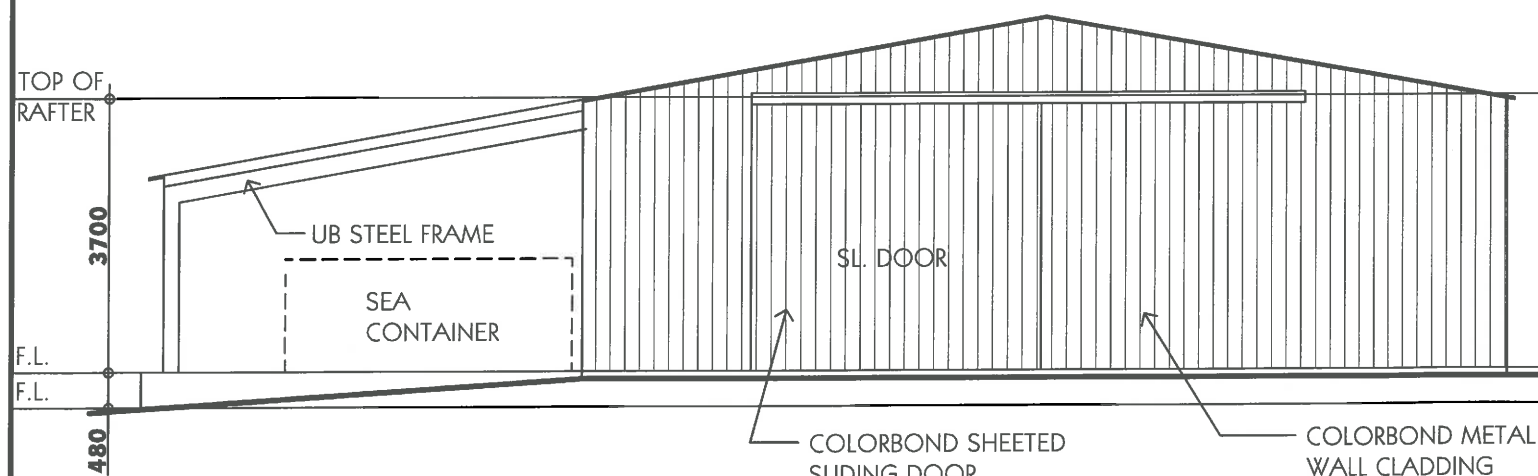


NORTH ELEVATION

1:100


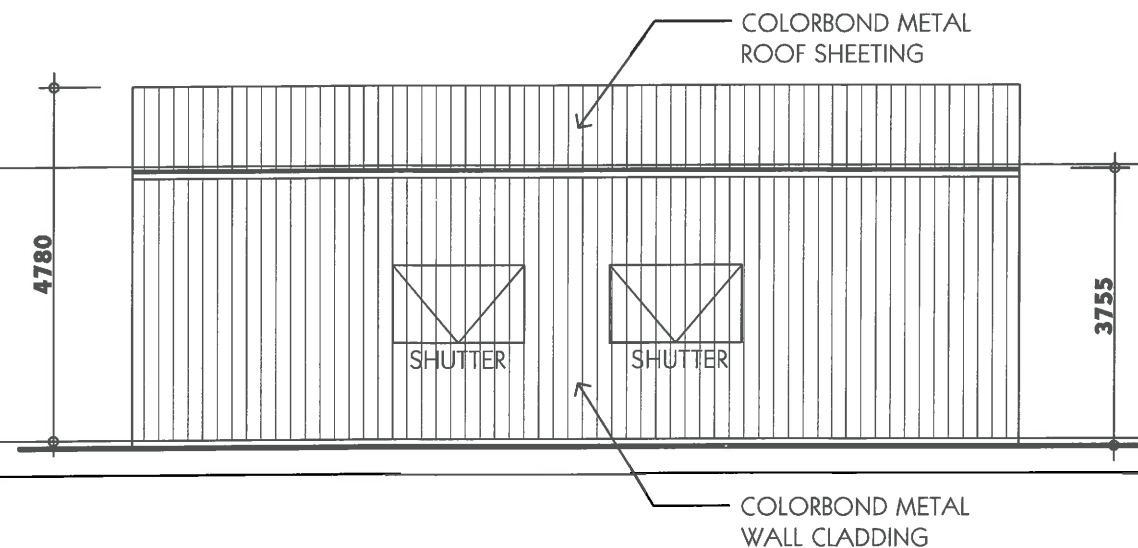



WEST ELEVATION

1:100

REVISIONS							DESIGN				L.E.ROBERTS BUILDING DESIGN			Suite 2A T1 Hedland Place PO Box 1219 Karratha 6714 Tel (08) 9164 2946 Fax (08) 9165 6990 Email: lawrance.roberts@leroberts.com.au Web: leroberts.com.au		
							DRAWN	AS	3/11/15		ARCHITECTURAL DESIGN CONSULTANTS			SCALE 1:100 (A3)		
							CHECKED	LER	17/11/15							
							ENGINEER	-	-							
							ISSUED				<div>DIVERSE GROUP AUSTRALIA 7-9 WILSON WAY, WICKHAM WORKSHOP 2 & COVERED AREA 2 ELEVATIONS</div> <div>DRAWING No 815-01-06</div> <div>SHEET 6 OF 20</div>					
	0	AS	25-11-15	AS BUILT DRAWING ISSUE		LER	CONTRACTOR TO CHECK ALL DIMENSIONS PRIOR TO COMMENCEMENT				<div>DRAWING No 815-01-06</div> <div>SHEET 6 OF 20</div>					
	REV	BY	DATE	DESCRIPTION	CKD	APP	DIMENSIONS TO GOVERN SCALE									

RECEIVED
City of Karratha
11 JAN 2016
Planning Department

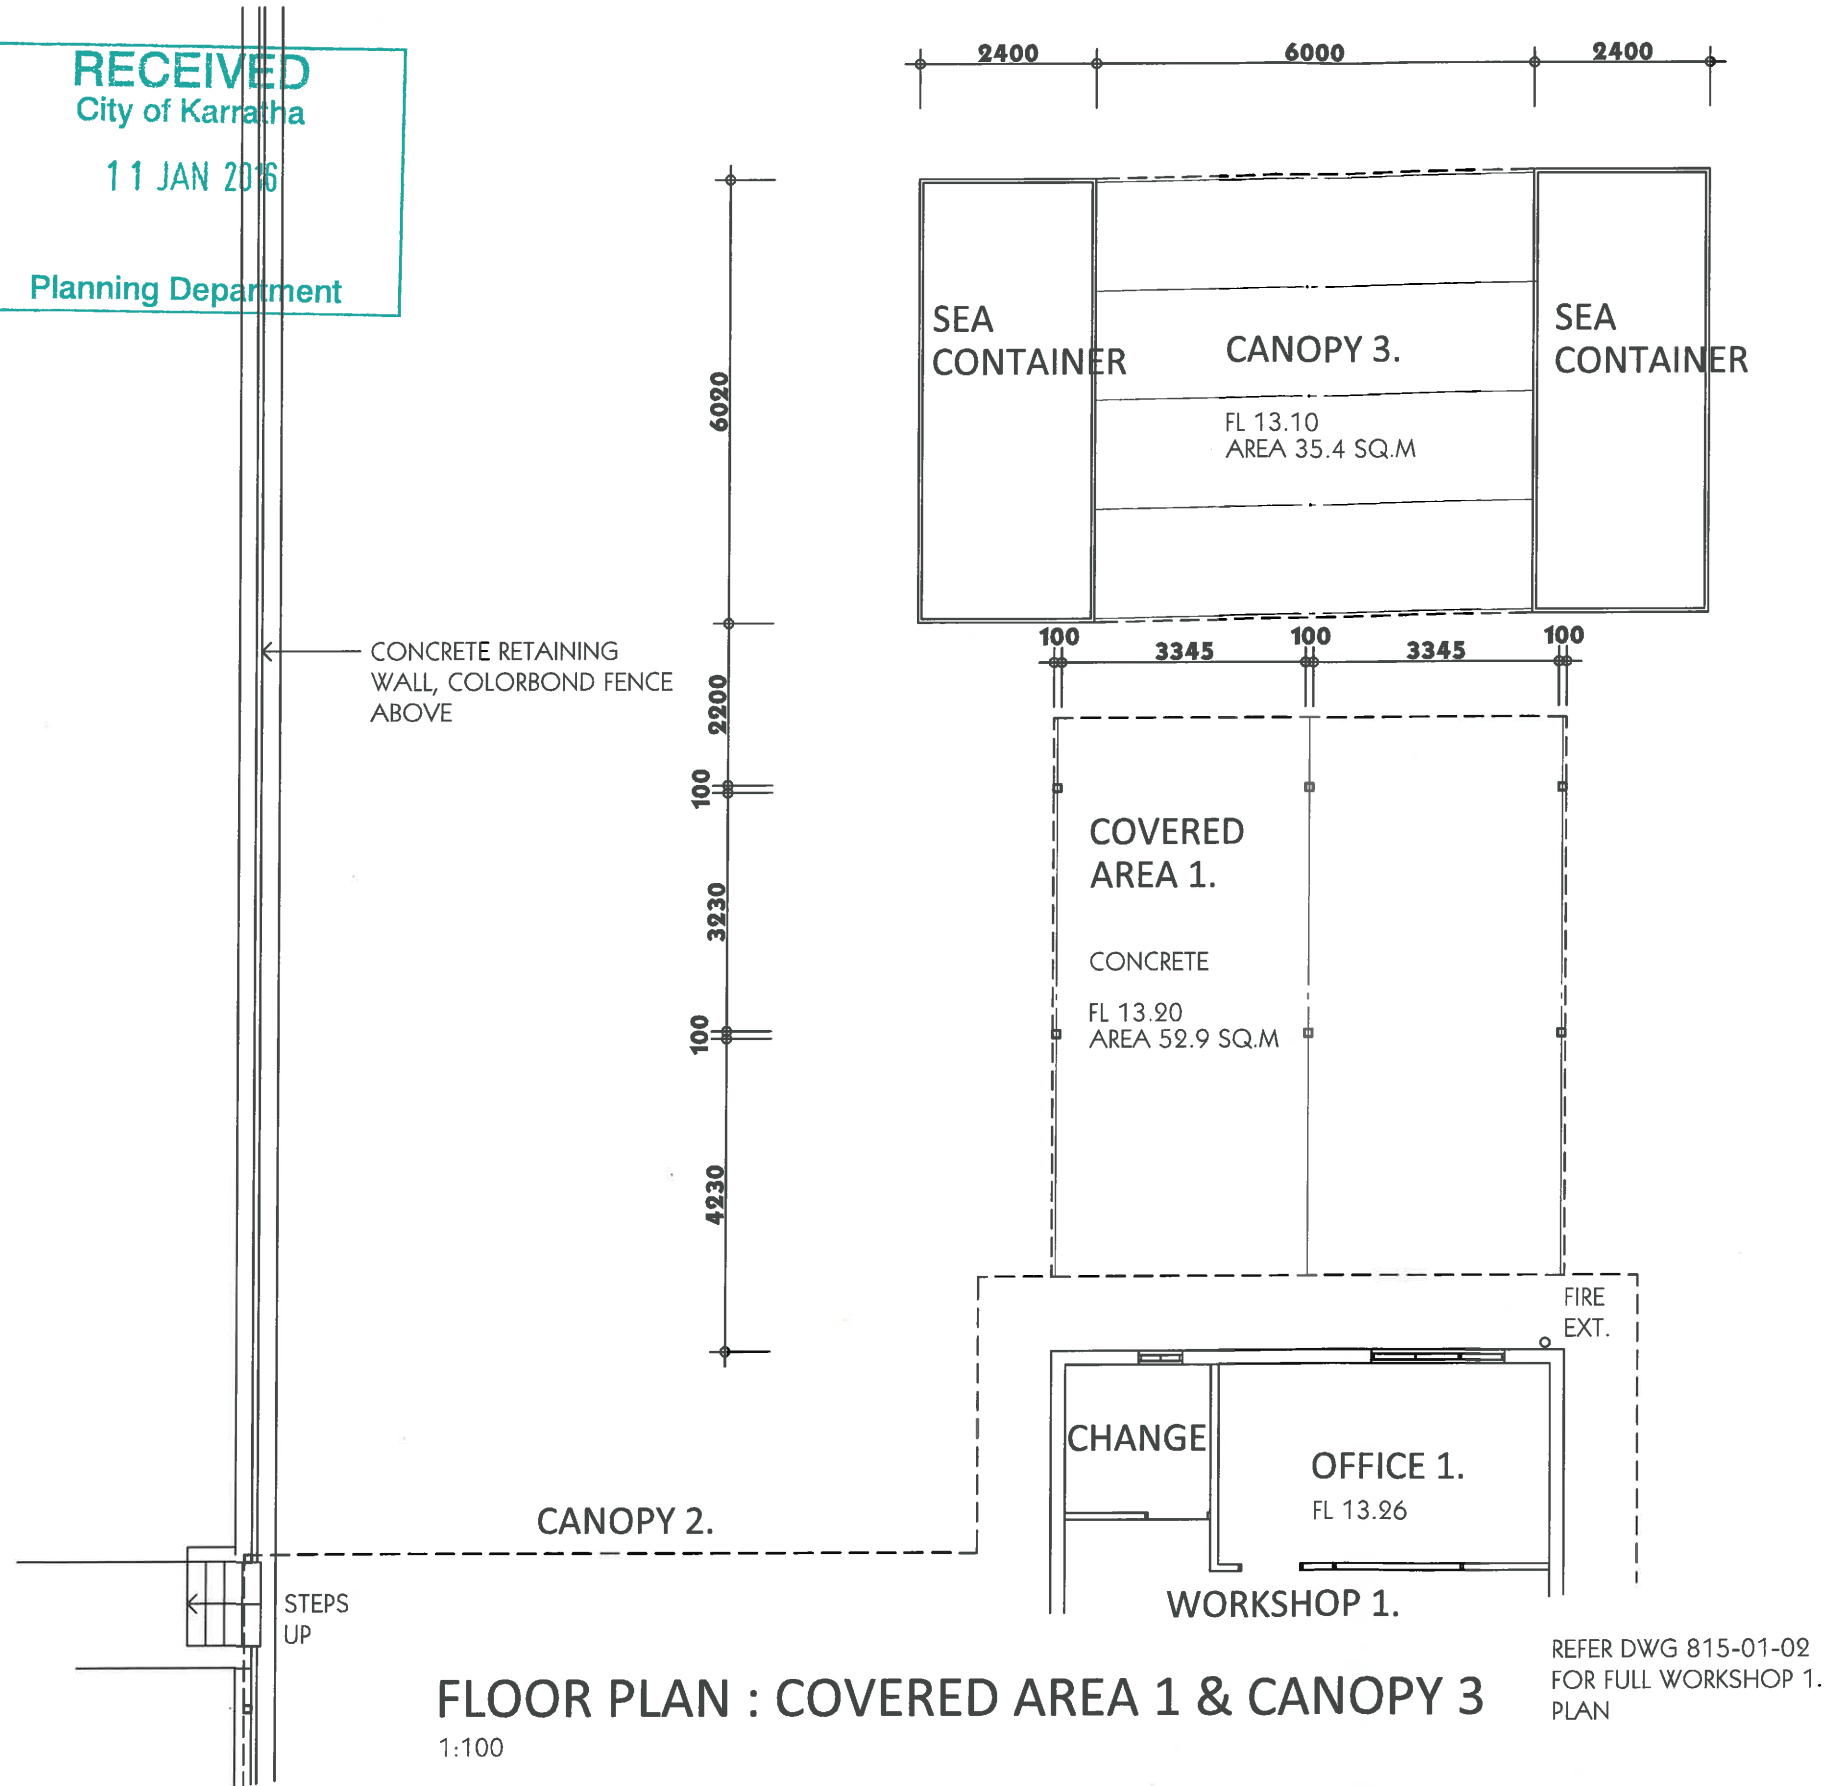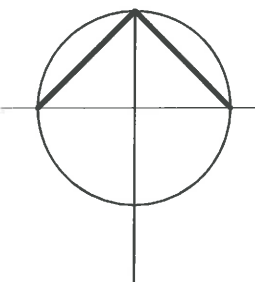

REVISIONS								DESIGN							L.E.ROBERTS BUILDING DESIGN ARCHITECTURAL DESIGN CONSULTANTS Suite 2A 11 Hedland Place PO Box 1219 Karratha 6714 Tel (08) 9144 2044 Fax (08) 9185 6090 Email: laurance.roberts@leroberts.com.au Web: leroberts.com.au			
								DRAWN	AS	3/11/15								
								CHECKED	LER	17/11/15								
								ENGINEER	-	-								
								ISSUED					DIVERSE GROUP AUSTRALIA 7-9 WILSON WAY, WICKHAM COVERED AREA 1 & CANOPY 3 FLOOR PLAN					
								CONTRACTOR TO CHECK ALL DIMENSIONS PRIOR TO COMMENCEMENT										
								DIMENSIONS TO GOVERN SCALE										
																SCALE	1:100 (A3)	
																DRAWING No	815-01-07	0
																SHEET	7 OF 20	
	0	AS	25-11-15	AS BUILT DRAWING ISSUE	LER													
	REV	BY	DATE	DESCRIPTION	CKD	APP												

RECEIVED

City of Karratha

11 JAN 2016

Planning Department

PVC MEMBRANE ON
STEEL FRAMING

PITCH L.

3120

SEA CONTAINER

2680

4610

CANOPY 3.

SEA CONTAINER

F.L.

NORTH ELEVATION

1:100

PVC MEMBRANE ON
STEEL FRAMING

METAL FASCIA

PVC MEMBRANE ON
STEEL FRAMING

U/SIDE
FASCIA

2905

SL. DOOR

CONCRETE
BLOCK

SHS POSTS

4610

SEA CONTAINER

F.L.

EAST ELEVATION

1:100

REV	BY	DATE	DESCRIPTION	CKD	APP	DESIGN	
						DRAWN	AS 3/11/15
0	AS	25-11-15	AS BUILT DRAWING ISSUE	LER		CHECKED	LER 17/11/15
						ENGINEER	-
						ISSUED	
						CONTRACTOR TO CHECK ALL DIMENSIONS PRIOR TO COMMENCEMENT	
						DIMENSIONS TO GOVERN SCALE	

LER		L.E.ROBERTS BUILDING DESIGN		Suite 2A 11 Hedland Place PO Box 1219 Karratha 6715 Tel: (08) 9164 2044 Fax: (08) 9165 6090 Email: lawrence.roberts@leroberts.com.au Web: leroberts.com.au
		ARCHITECTURAL DESIGN CONSULTANTS		
DIVERSE GROUP AUSTRALIA 7-9 WILSON WAY, WICKHAM COVERED AREA 1 & CANOPY 3 ELEVATIONS		SCALE		1:100 (A3)
		DRAWING No		815-01-08 0
		SHEET		8 OF 20

THIS IS A CAD DRAWING
DO NOT AMEND MANUALLY