



GENERAL NOTES:

General Note:
This drawing is the exclusive property of CIVEO PTY LTD. No reproduction of any part thereof may be made without the written consent of CIVEO PTY LTD. It is to be used solely for the purpose of the project and is not to be used for any other purpose. CIVEO PTY LTD is not liable for any errors or omissions in this drawing and shall accept no responsibility for any consequences arising from the use of this drawing.

TOTAL ROOMS ON 'FREEHOLD' LAND - 480
TOTAL ROOMS ON 'LEASEHOLD' LAND - 794

Schedule:			
	EXISTING	ADDITIONAL PROPOSED	TOTAL
16m2 ROOMS - EX	216	-	216
24m2 ROOMS	38	-	38
24m2 ACCESSIBLE	2	-	2
12m2 REFURB. STAFF	42	-	42
NEW 16m2 ROOMS	-	972	972
NEW ACCESSIBLE	-	4	4
ROOMS	298	976	1274
CARPARKING	172	518	690
LAUNDRIES	3	6	9

NOTE : DA APPROVAL 1274 ROOMS AND 690 CARS

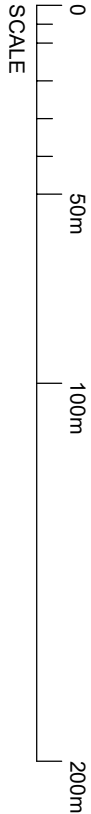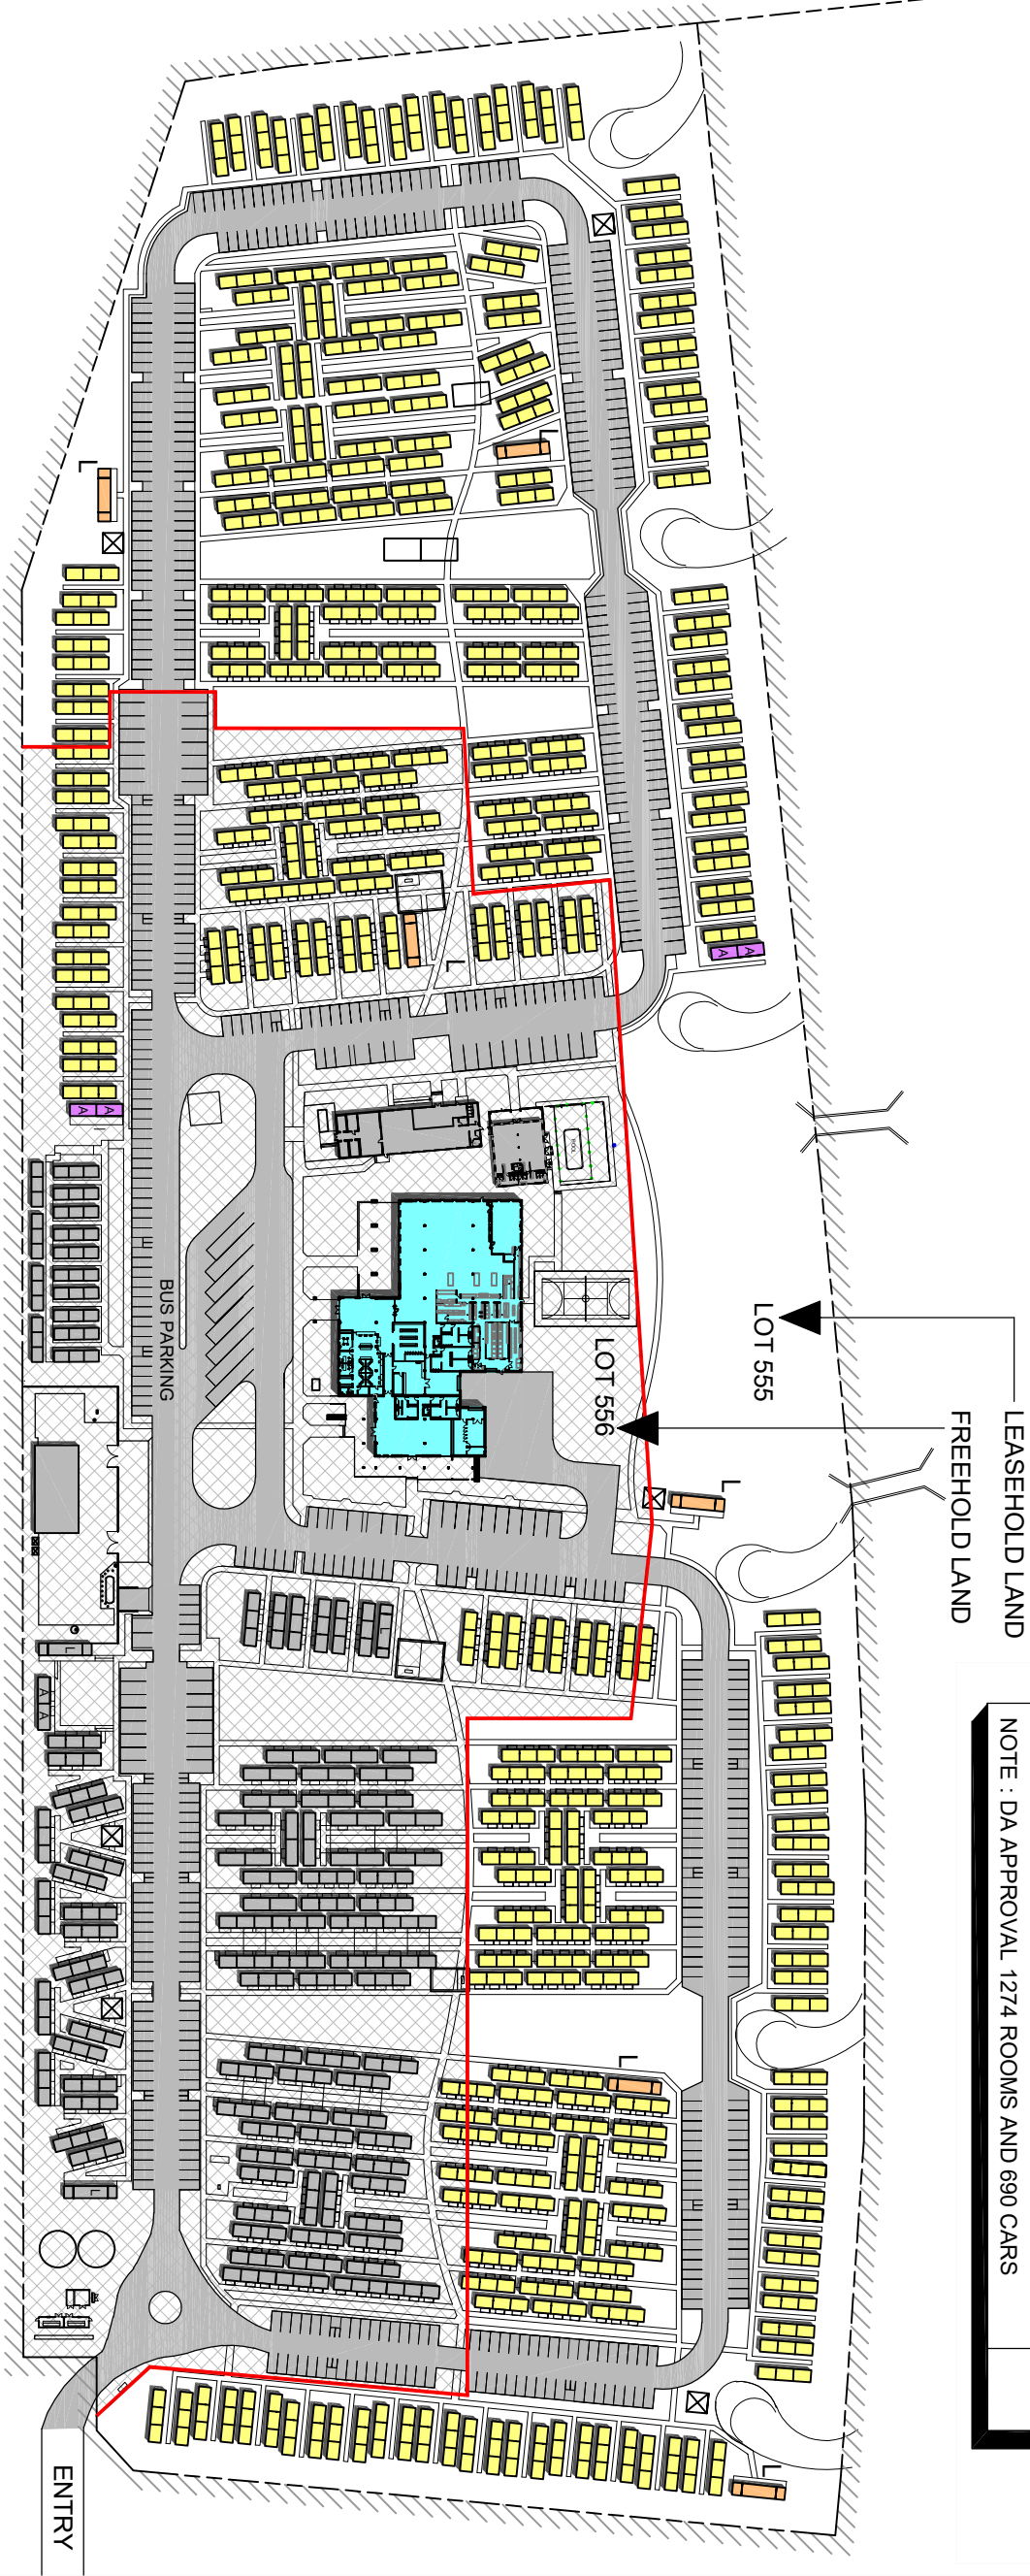

KARRATHA - CURRENT DA APPROVED SITE PLAN

1



PROJECT:
KARRATHA 588 ROOMS

DRAWING TITLE:
CURRENT DA APPROVED
SITE PLAN

DATE: 26.10.20	SCALE: 1:2000	PROJECT NO: 2020-20	DRAWING NO: SK-01
DESIGN BY: HH	PHASE: PH		

USE OF THIS DRAWING IS LIMITED TO THE PROJECT AND SHALL BE VOID IF USED FOR ANY OTHER PURPOSE. CIVEO PTY LTD IS NOT RESPONSIBLE FOR ANY CONSEQUENCES ARISING FROM THE USE OF THIS DRAWING.


CAD FILE: 01

GENERAL NOTES:

General Note:
This drawing is the exclusive property of CIVEO PTY LTD. Any reproduction of any part thereof prior written consent from this office is a violation of copyright rules.
In no event shall CIVEO PTY LTD be made liable for special, incidental, or consequential damages in connection with the use of digital data once out of CIVEO office.



Schedule:		
	EXISTING	
16m2 ROOMS	216	
24m2 ROOMS	38	
24m2 ACCESSIBLE	2	
16m2 FLY CAMP	42	
ROOMS	298	
CARPARKING	172	
LAUNDRIES	3	

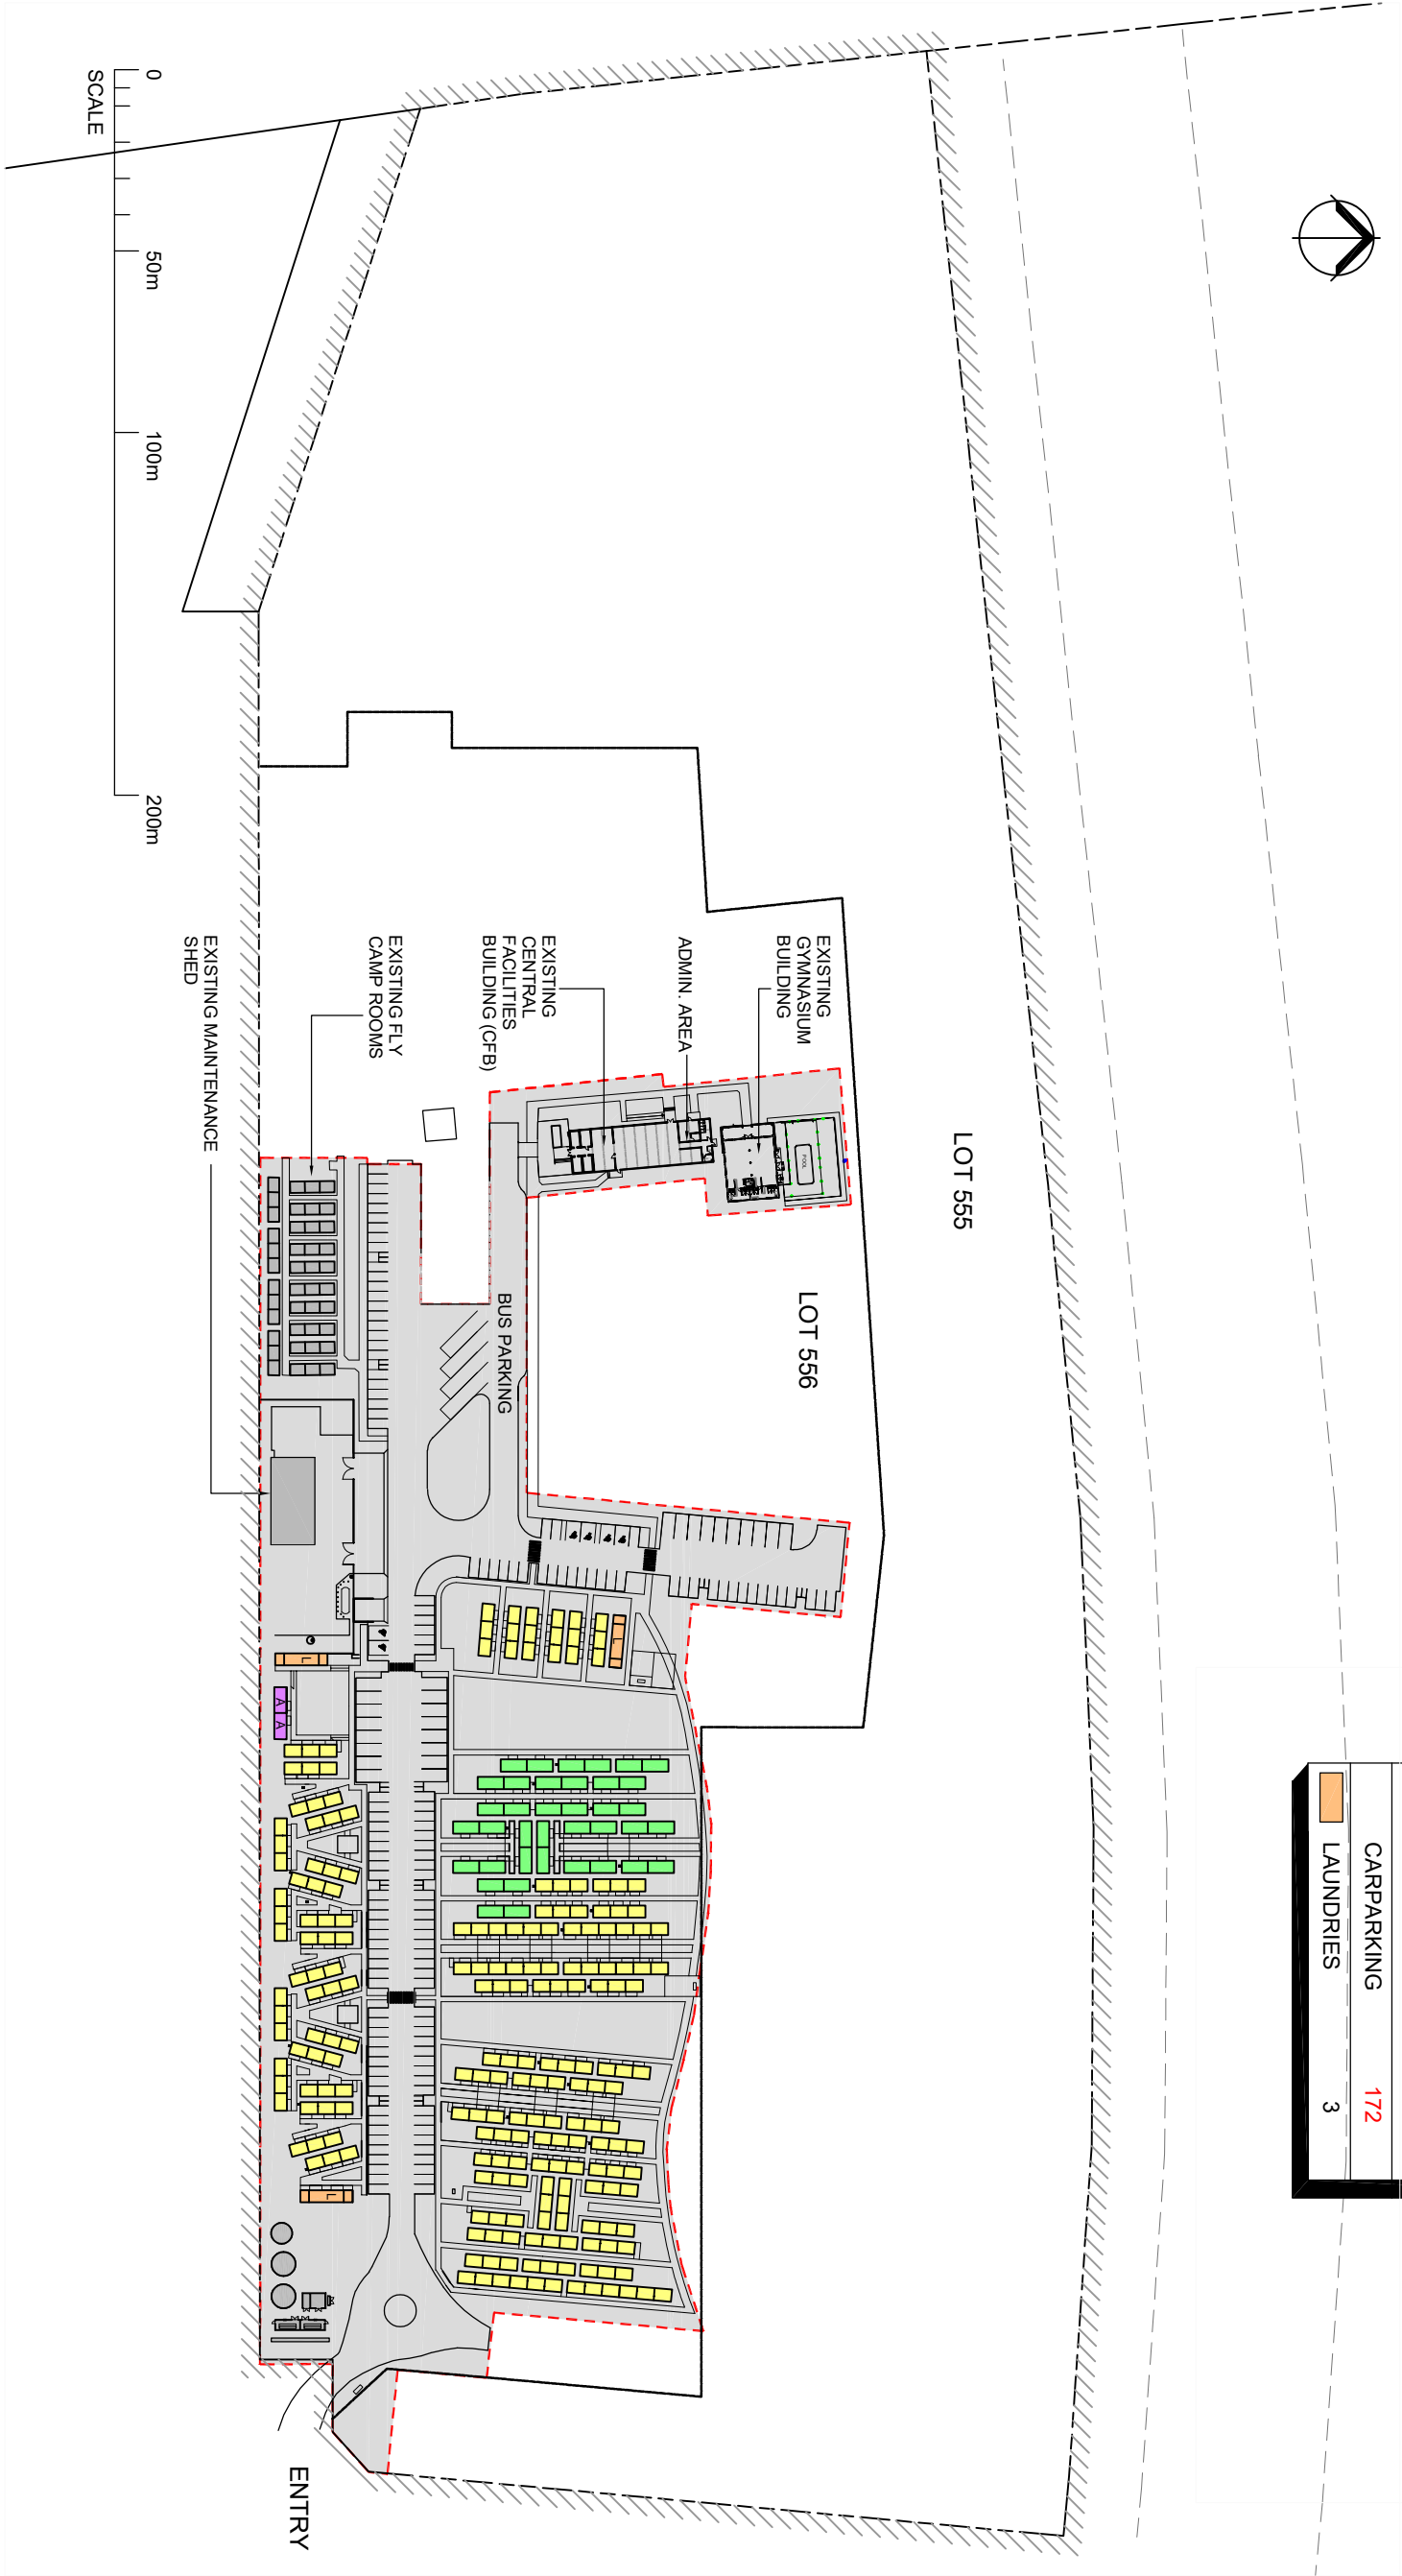

KARRATHA - CURRENT SITE PLAN - AS BUILT

1



PROJECT:

KARRATHA 588 ROOMS

DRAWING TITLE:

CURRENT SITE PLAN

DATE:	SCALE:	PROJECT No:	DRAWING No:
26.10.20	1:2000	2020-20	SK-02
DESIGN BY:	DRAWN BY:	PHASE:	
KH	KH		

USE OF THIS DRAWING IS LIMITED TO THE PROJECT AND SHALL BE VOID IF NOT APPROVED BY CIVEO AND SHALL BE VOID IF NOT APPROVED BY THE CLIENT OF WORK & SIGNING THE CONSTRUCTION PAGE


GENERAL NOTES:







General Note:
This drawing is the exclusive property of CIVEO PTY LTD. The reproduction of any part thereof prior written consent from this office is a violation of copyright laws.
It is to be noted that CIVEO PTY LTD. is made solely for special conditions, including or consequential liabilities in connection with the use of digital data once out of CIVEO office.

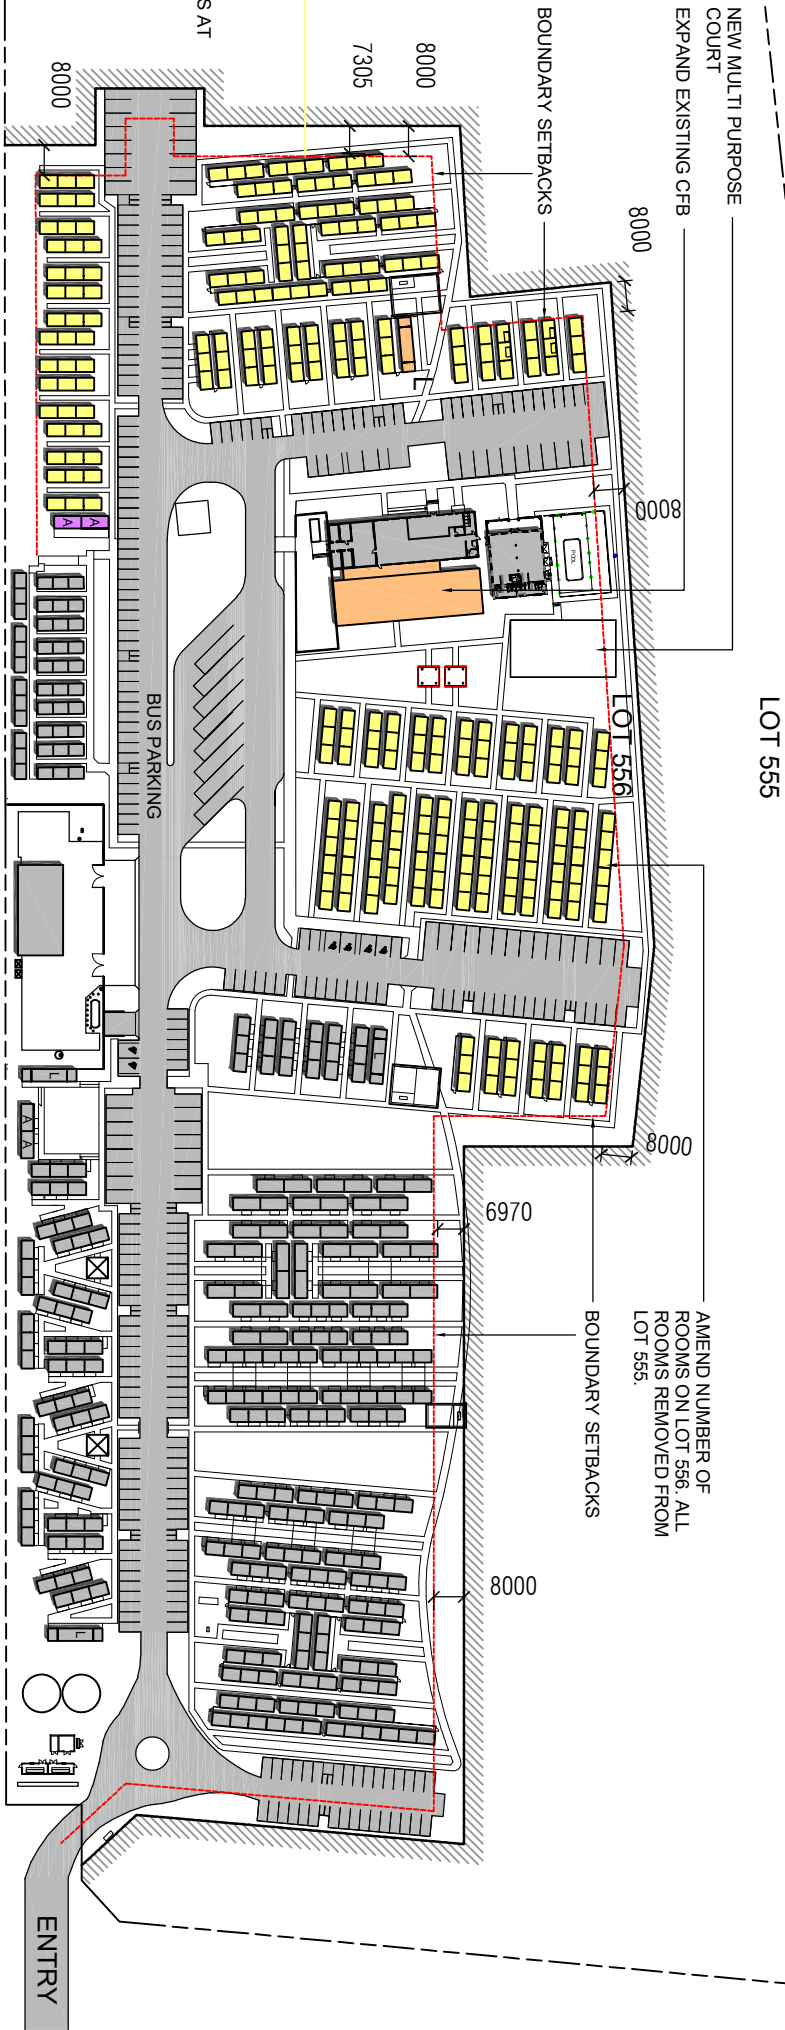

AREA OF LOT 556 - 65,458m2
AREA OF LOT 555 - 73,742m2

PROPOSED NEW
ACCOMMODATION
BUILDINGS, 3 ROOMS AT
16m2 PER ROOM.



Schedule: Option 03			
	EXISTING	ADDITIONAL PROPOSED	TOTAL
 16m2 ROOMS - EX	216	-	216
 24m2 ROOMS	38	-	38
 24m2 ACCESSIBLE	2	-	2
 12m2 REFURB. STAFF	42	-	42
 NEW 16m2 ROOMS	-	288	288
 NEW ACCESSIBLE	-	2	2
ROOMS	298	290	588
CARPARKING	172	150	322
LAUNDRIES	3	1	4

NOTE : DA APPROVAL 1274 ROOMS AND 690 CARS

KARRATHA - PROPOSED SITE PLAN

1

NOTE:
FOR SUBMISSION TO COUNCIL FOR
APPROVAL.



PROJECT:
KARRATHA 588 ROOMS

DRAWING TITLE:

PROPOSED SITE PLAN


DATE: 26.10.20	SCALE: 1:2000	PROJECT No: 2020-20	DRAWING No: SK-03
DESIGN BY: KH	DRAWN BY: KH	PHASE: SK-03	

USE OF DRAWING: THIS DRAWING IS THE PROPERTY OF CIVEO PTY LTD. AND IS NOT TO BE REPRODUCED OR USED IN ANY MANNER WITHOUT THE WRITTEN CONSENT OF CIVEO PTY LTD. ANY UNAUTHORIZED USE OF THIS DRAWING WILL BE AT THE USER'S SOLE RISK AND WITHOUT LIABILITY TO CIVEO PTY LTD.


CAD FILE: 01

GENERAL NOTES:


General Note:
This drawing is the exclusive property of CIVEO PTY LTD. Any reproduction of any part without prior written consent from this office is a violation of copyright rules.
It is to avoid dual CIVEO PTY LTD to make scale for special conditions, included or consequential liability in connection with the use of digital data once out of CIVEO office.

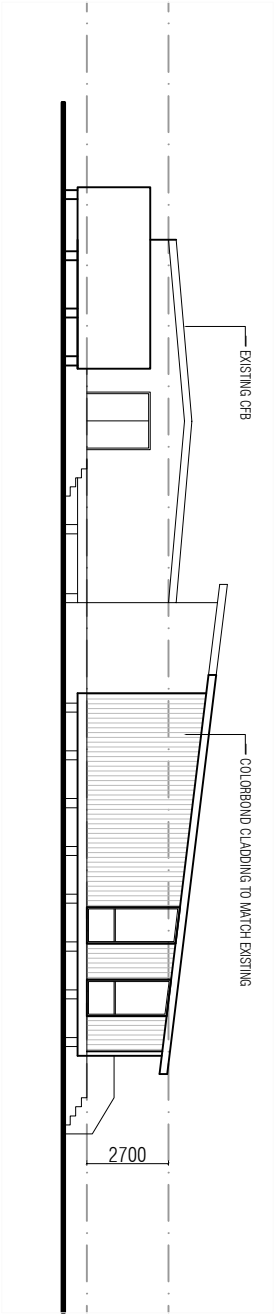

CFB - SOUTHERN ELEVATION

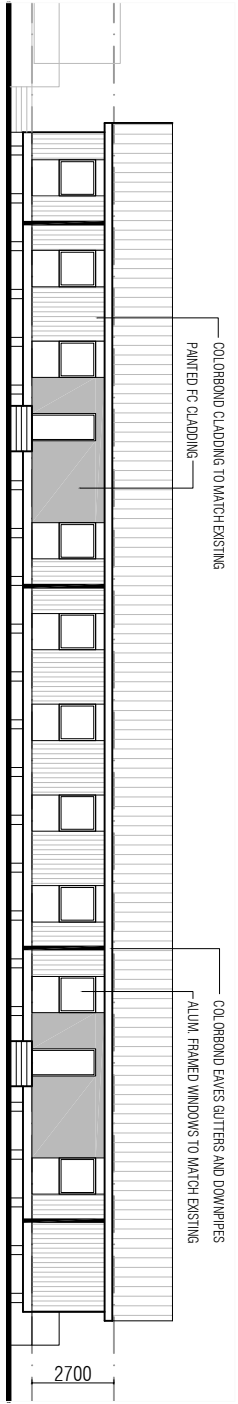


CFB - EASTERN ELEVATION

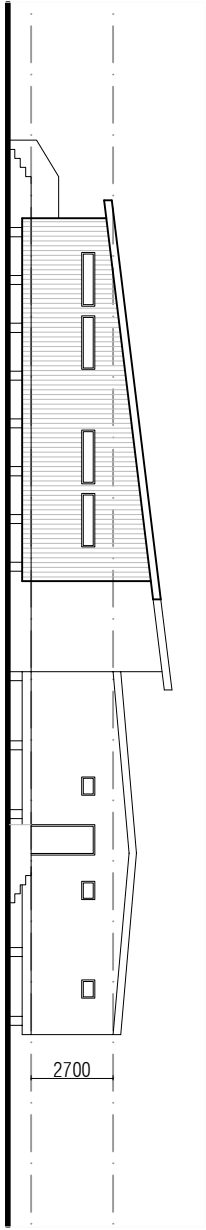

CFB - NORTHERN ELEVATION

AREAS	EXISTING	EXTENSION
DINING / CRIB	197m2	370m2
AMENITIES	35m2	35m2
KITCHEN	166m2	126m2
RETAIL/ADMIN	56m2	-
EXTERNAL STORAGE	15m2	-

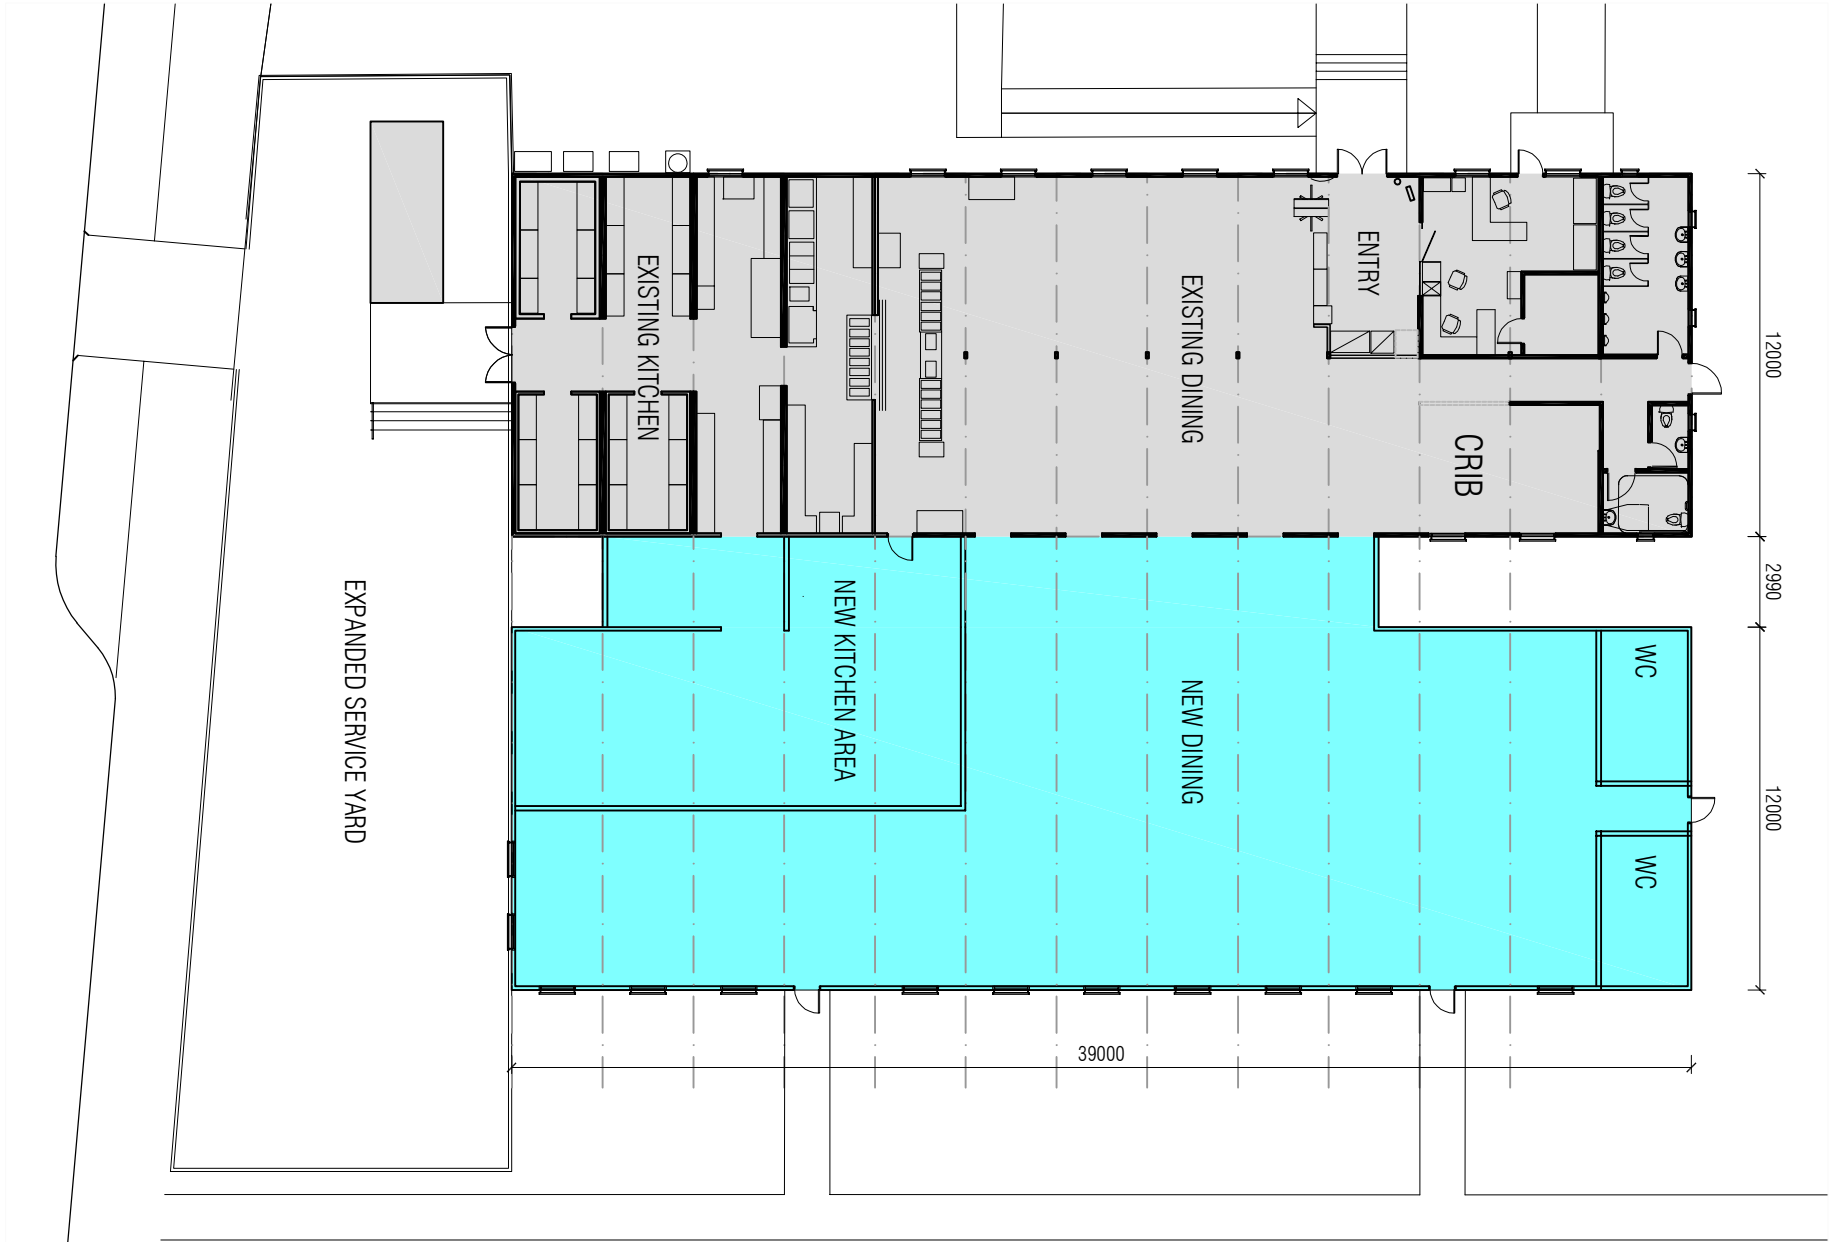

KARRATHA - PROPOSED NEW CFB



PROJECT:
KARRATHA 588 ROOMS

DRAWING TITLE:
PROPOSED CFB

DATE: 26.10.20	SCALE: 1:250	PROJECT No: 2020-20	DRAWING No: SK-04
DESIGN BY: KH	PHASE: KH		

USE FOR EXISTING OFFICE
RESPONSIBLE TO CIVEO AND CIVIL ENGINEER
NO LIABILITY IN THE NEW BUILDING MAY
BE INCURRED BY CIVEO AND CIVIL ENGINEER
SHEET OF 01 & 02 THE CONSTRUCTION WORK