


GENERAL NOTES:

General Note:
This drawing is the exclusive property of CIVEO PTY LTD. No reproduction of any part thereof prior written consent from this office is a violation of copyright laws.
It is to be used solely (CIVEO PTY LTD) to make bids for specific construction, incidental or consequential liability is connection with the use of digital data once out of CIVEO office.

TOTAL ROOMS ON 'FREEHOLD' LAND - 480
TOTAL ROOMS ON 'LEASEHOLD' LAND - 794

Schedule:			
	EXISTING	ADDITIONAL PROPOSED	TOTAL
<div></div> 16m2 ROOMS - EX	216	-	216
<div></div> 24m2 ROOMS	38	-	38
<div>A</div> 24m2 ACCESSIBLE	2	-	2
<div></div> 12m2 REFURB. STAFF	42	-	42
<div></div> NEW 16m2 ROOMS	-	972	972
<div>A A A</div> NEW ACCESSIBLE	-	4	4
ROOMS	298	976	1274
CARPARKING	172	518	690
LAUNDRIES	3	6	9

NOTE : DA APPROVAL 1274 ROOMS AND 690 CARS

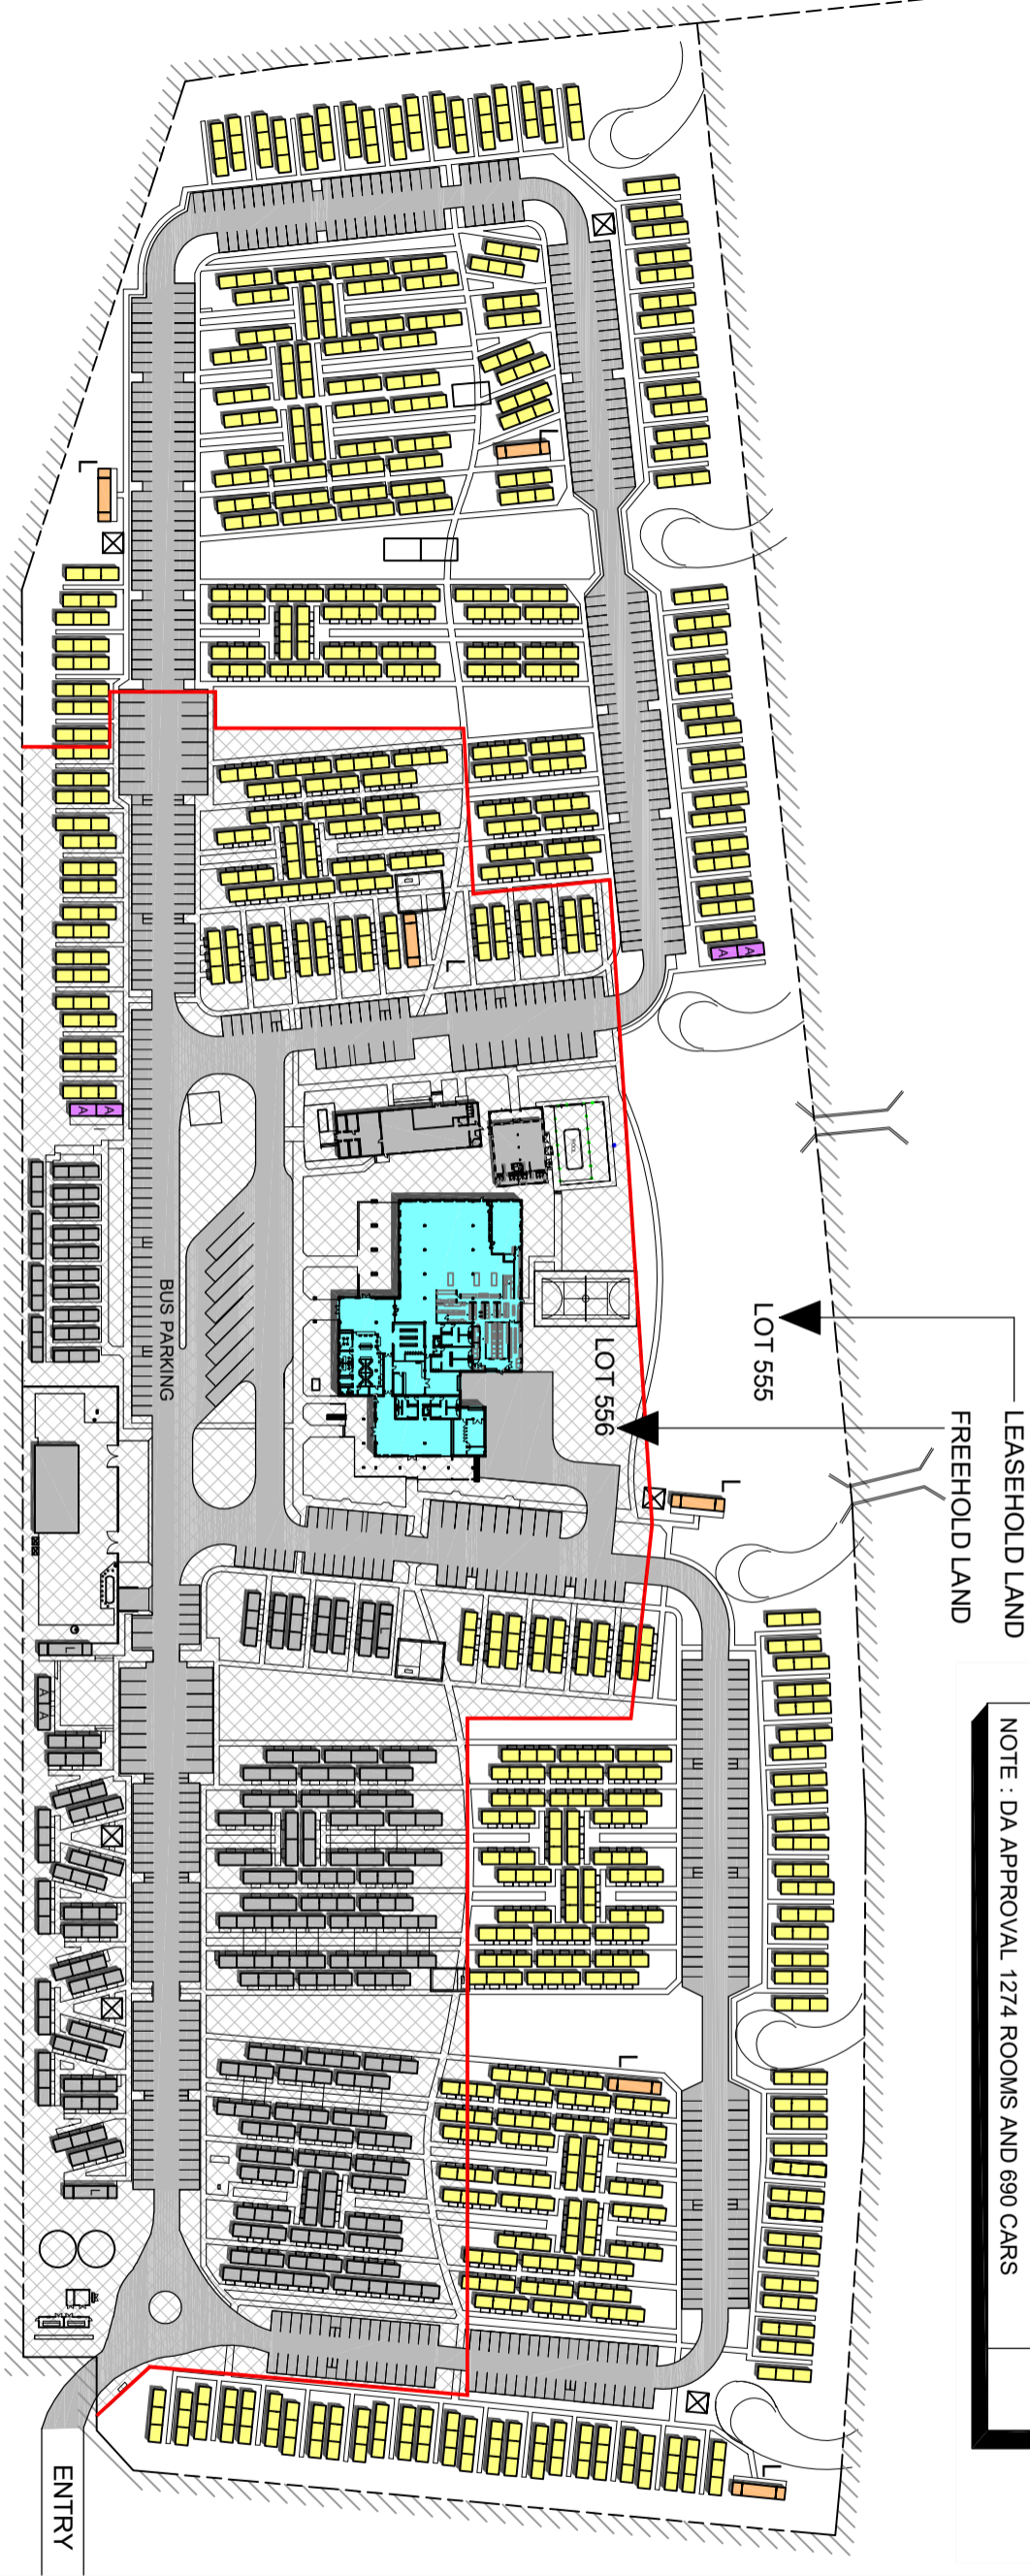

KARRATHA - CURRENT DA APPROVED SITE PLAN

1



PROJECT:
KARRATHA 588 ROOMS

DRAWING TITLE:
CURRENT DA APPROVED
SITE PLAN

DATE: 26.10.20	SCALE: 1:2000	PROJECT NO: 2020-20	DRAWING NO: SK-01
DESIGN BY: HH	PHASE: PH	REVISION: 01	



GENERAL NOTES:

General Note:
This drawing is the exclusive property of CIVEO PTY LTD. Any reproduction of any part thereof prior written consent from this office is a violation of copyright rules.
In no event shall CIVEO PTY LTD be made liable for special, incidental, incidental or consequential damages in connection with the use of digital data once out of CIVEO office.



Schedule:		
	EXISTING	
16m2 ROOMS	216	
24m2 ROOMS	38	
24m2 ACCESSIBLE	2	
16m2 FLY CAMP	42	
ROOMS	298	
CARPARKING	172	
LAUNDRIES	3	

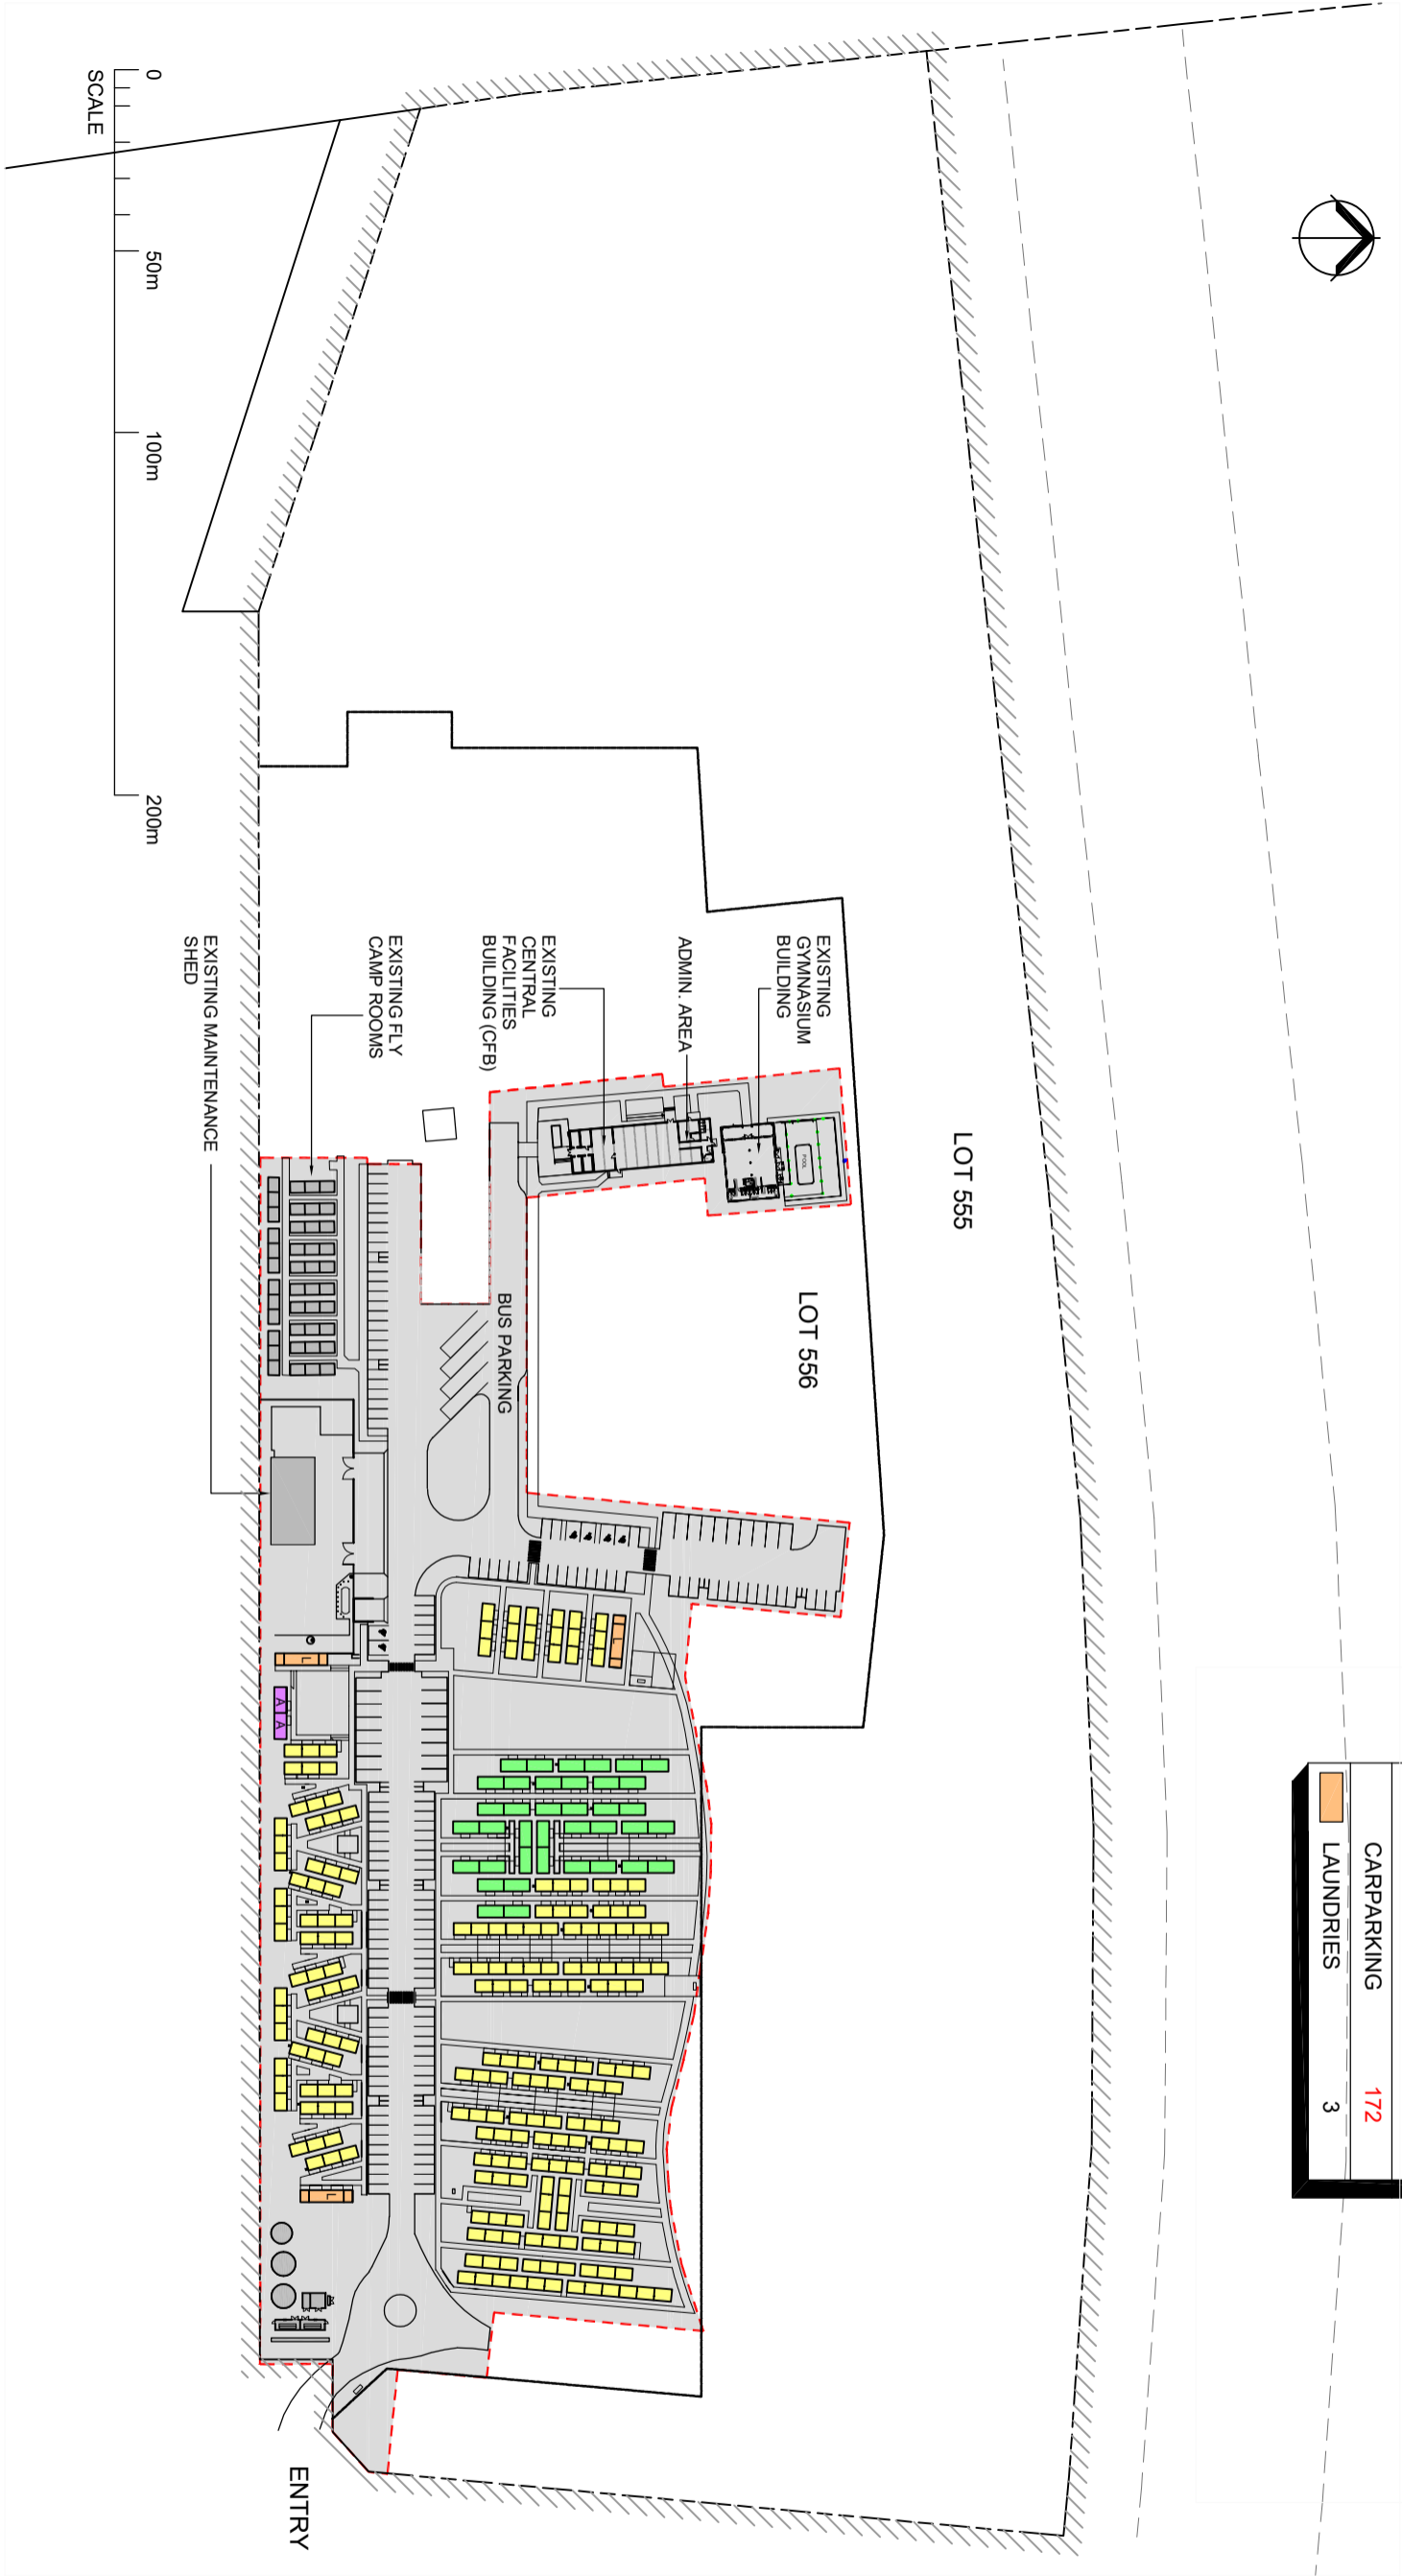

KARRATHA - CURRENT SITE PLAN - AS BUILT

1



PROJECT:

KARRATHA 588 ROOMS

DRAWING TITLE:

CURRENT SITE PLAN

DATE:	SCALE:	PROJECT No:	DRAWING No:
26.10.20	1:2000	2020-20	SK-02
DESIGN BY:	DRAWN BY:	PHASE:	
KH	KH		

USE OF THIS DRAWING IS LIMITED TO THE PROJECT AND SHALL BE VOID IF NOT USED IN CONNECTION WITH THE PROJECT. ANY REUSE OF THIS DRAWING FOR ANY OTHER PROJECT WITHOUT THE WRITTEN CONSENT OF CIVEO IS A VIOLATION OF THE COPYRIGHT LAWS OF AUSTRALIA.


GENERAL NOTES:

General Note:
This drawing is the exclusive property of CIVEO PTY LTD. The reproduction of any part without prior written consent from this office is a violation of copyright laws.
It is to be noted that CIVEO PTY LTD. is made solely for special conditions, including or consequential liabilities in connection with the use of digital data once out of CIVEO office.



AREA OF LOT 556 - 65,458m2
AREA OF LOT 555 - 73,742m2

PROPOSED NEW
ACCOMMODATION
BUILDINGS, 3 ROOMS AT
16m2 PER ROOM.

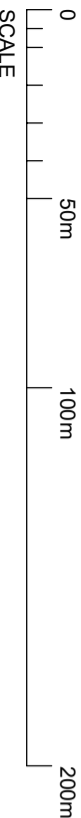

KARRATHA - PROPOSED SITE PLAN

1

NOTE:
FOR SUBMISSION TO COUNCIL FOR
APPROVAL.

Schedule: Option 03			
	EXISTING	ADDITIONAL PROPOSED	TOTAL
16m2 ROOMS - EX	216	-	216
24m2 ROOMS	38	-	38
24m2 ACCESSIBLE	2	-	2
12m2 REFURB. STAFF	42	-	42
NEW 16m2 ROOMS	-	288	288
NEW ACCESSIBLE	-	2	2
ROOMS	298	290	588
CARPARKING	172	150	322
LAUNDRIES	3	1	4

NOTE : DA APPROVAL 1274 ROOMS AND 690 CARS

GENERAL NOTES:

General Note:
This drawing is the exclusive property of CIVEO PTY LTD. The reproduction of any part without prior written consent from this office is a violation of copyright laws.
It is to be noted that CIVEO PTY LTD. is made solely for special conditions, including or consequential liabilities in connection with the use of digital data once out of CIVEO office.



PROJECT:
KARRATHA 588 ROOMS

DRAWING TITLE:

PROPOSED SITE PLAN


DATE:	SCALE:	PROJECT No:	DRAWING No:
26.10.20	1:2000	2020-20	SK-03
DESIGN BY:	DRAWN BY:	PHASE:	
KH	KH		

USE OF DRAWING: THIS DRAWING IS THE PROPERTY OF CIVEO PTY LTD. AND IS NOT TO BE REPRODUCED OR USED IN ANY MANNER WITHOUT THE WRITTEN CONSENT OF CIVEO PTY LTD. ANY REPRODUCTION OR USE OF THIS DRAWING WITHOUT THE WRITTEN CONSENT OF CIVEO PTY LTD. IS A VIOLATION OF COPYRIGHT LAWS.


CAD FILE: 01

GENERAL NOTES:


General Note:
This drawing is the exclusive property of CIVEO PTY LTD. Any reproduction of any part without prior written consent from this office is a violation of copyright laws.
It is to be noted that CIVEO PTY LTD. is made solely for special conditions, including or consequential liabilities in connection with the use of digital data once out of CIVEO office.

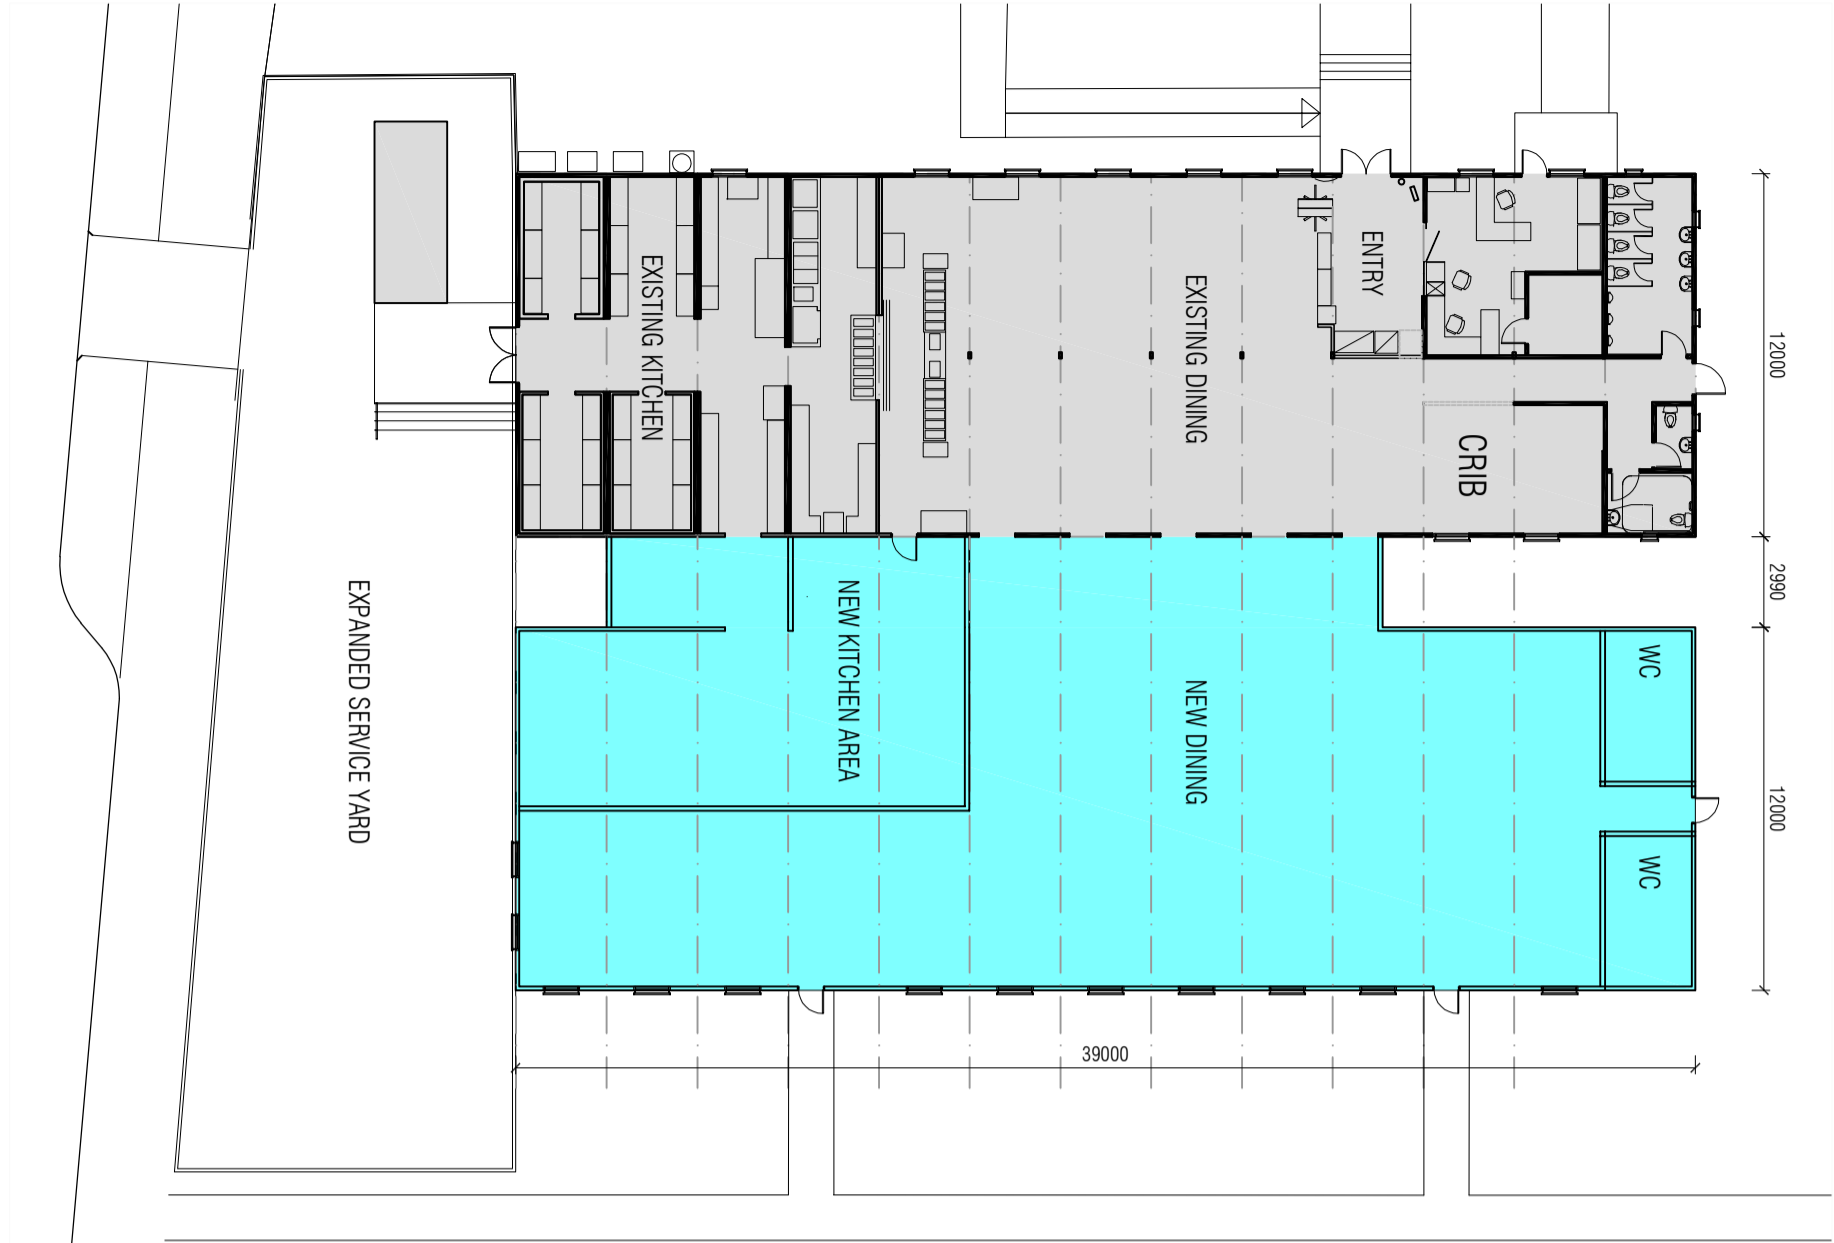


1 KARRATHA - PROPOSED NEW CFB

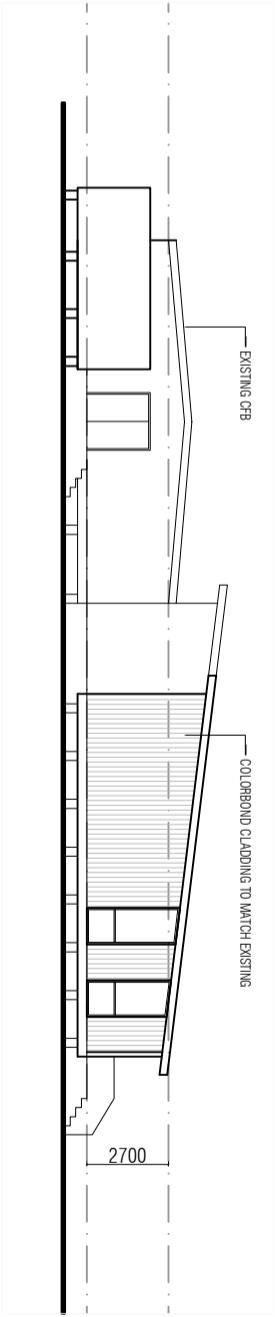

2 CFB - SOUTHERN ELEVATION

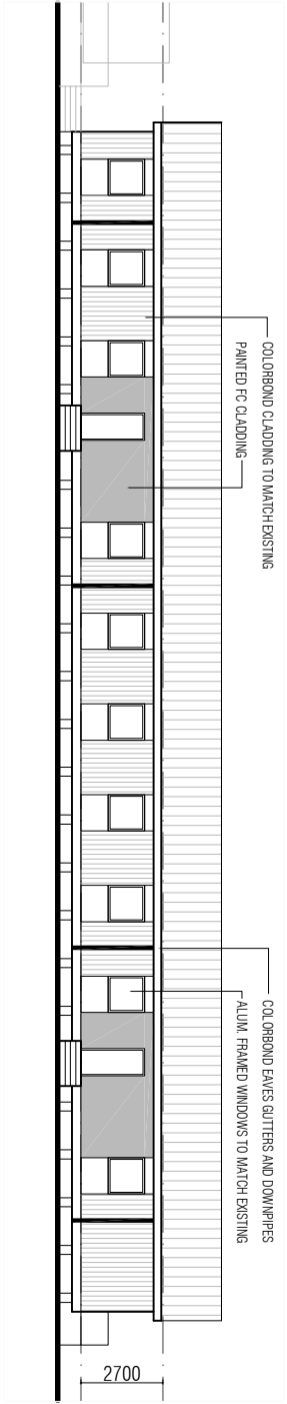

3 CFB - EASTERN ELEVATION

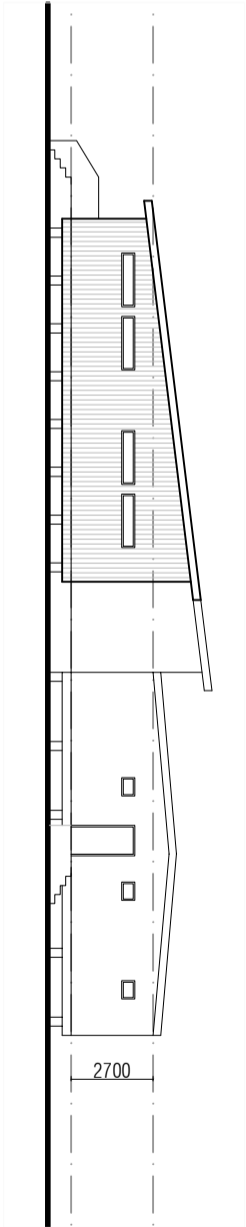

4 CFB - NORTHERN ELEVATION

AREAS	EXISTING	EXTENSION
DINING / CRIB	197m2	370m2
AMENITIES	35m2	35m2
KITCHEN	166m2	126m2
RETAIL/ADMIN	56m2	-
EXTERNAL STORAGE	15m2	-



PROJECT:
KARRATHA 588 ROOMS

DRAWING TITLE:

PROPOSED CFB

DATE: 26.10.20	SCALE: 1:250	PROJECT No: 2020-20	DRAWING No: SK-04
DESIGN BY: KH	PHASE: KH		

USE OF DRAWINGS: THESE OFFICE DRAWINGS ARE NOT TO BE USED FOR ANY OTHER PURPOSES WITHOUT THE WRITTEN CONSENT OF CIVEO PTY LTD. ANY REPRODUCTION OR MODIFICATION OF THESE DRAWINGS WITHOUT THE WRITTEN CONSENT OF CIVEO PTY LTD. IS A BREACH OF THE COPYRIGHT LAWS OF AUSTRALIA.

CAD FILE: 01